


50
50
50
50

Handwritten notes in the top right corner, including "Clear Run Mine No. 2" and "Sandy Twp., Clearfield County, Pa."

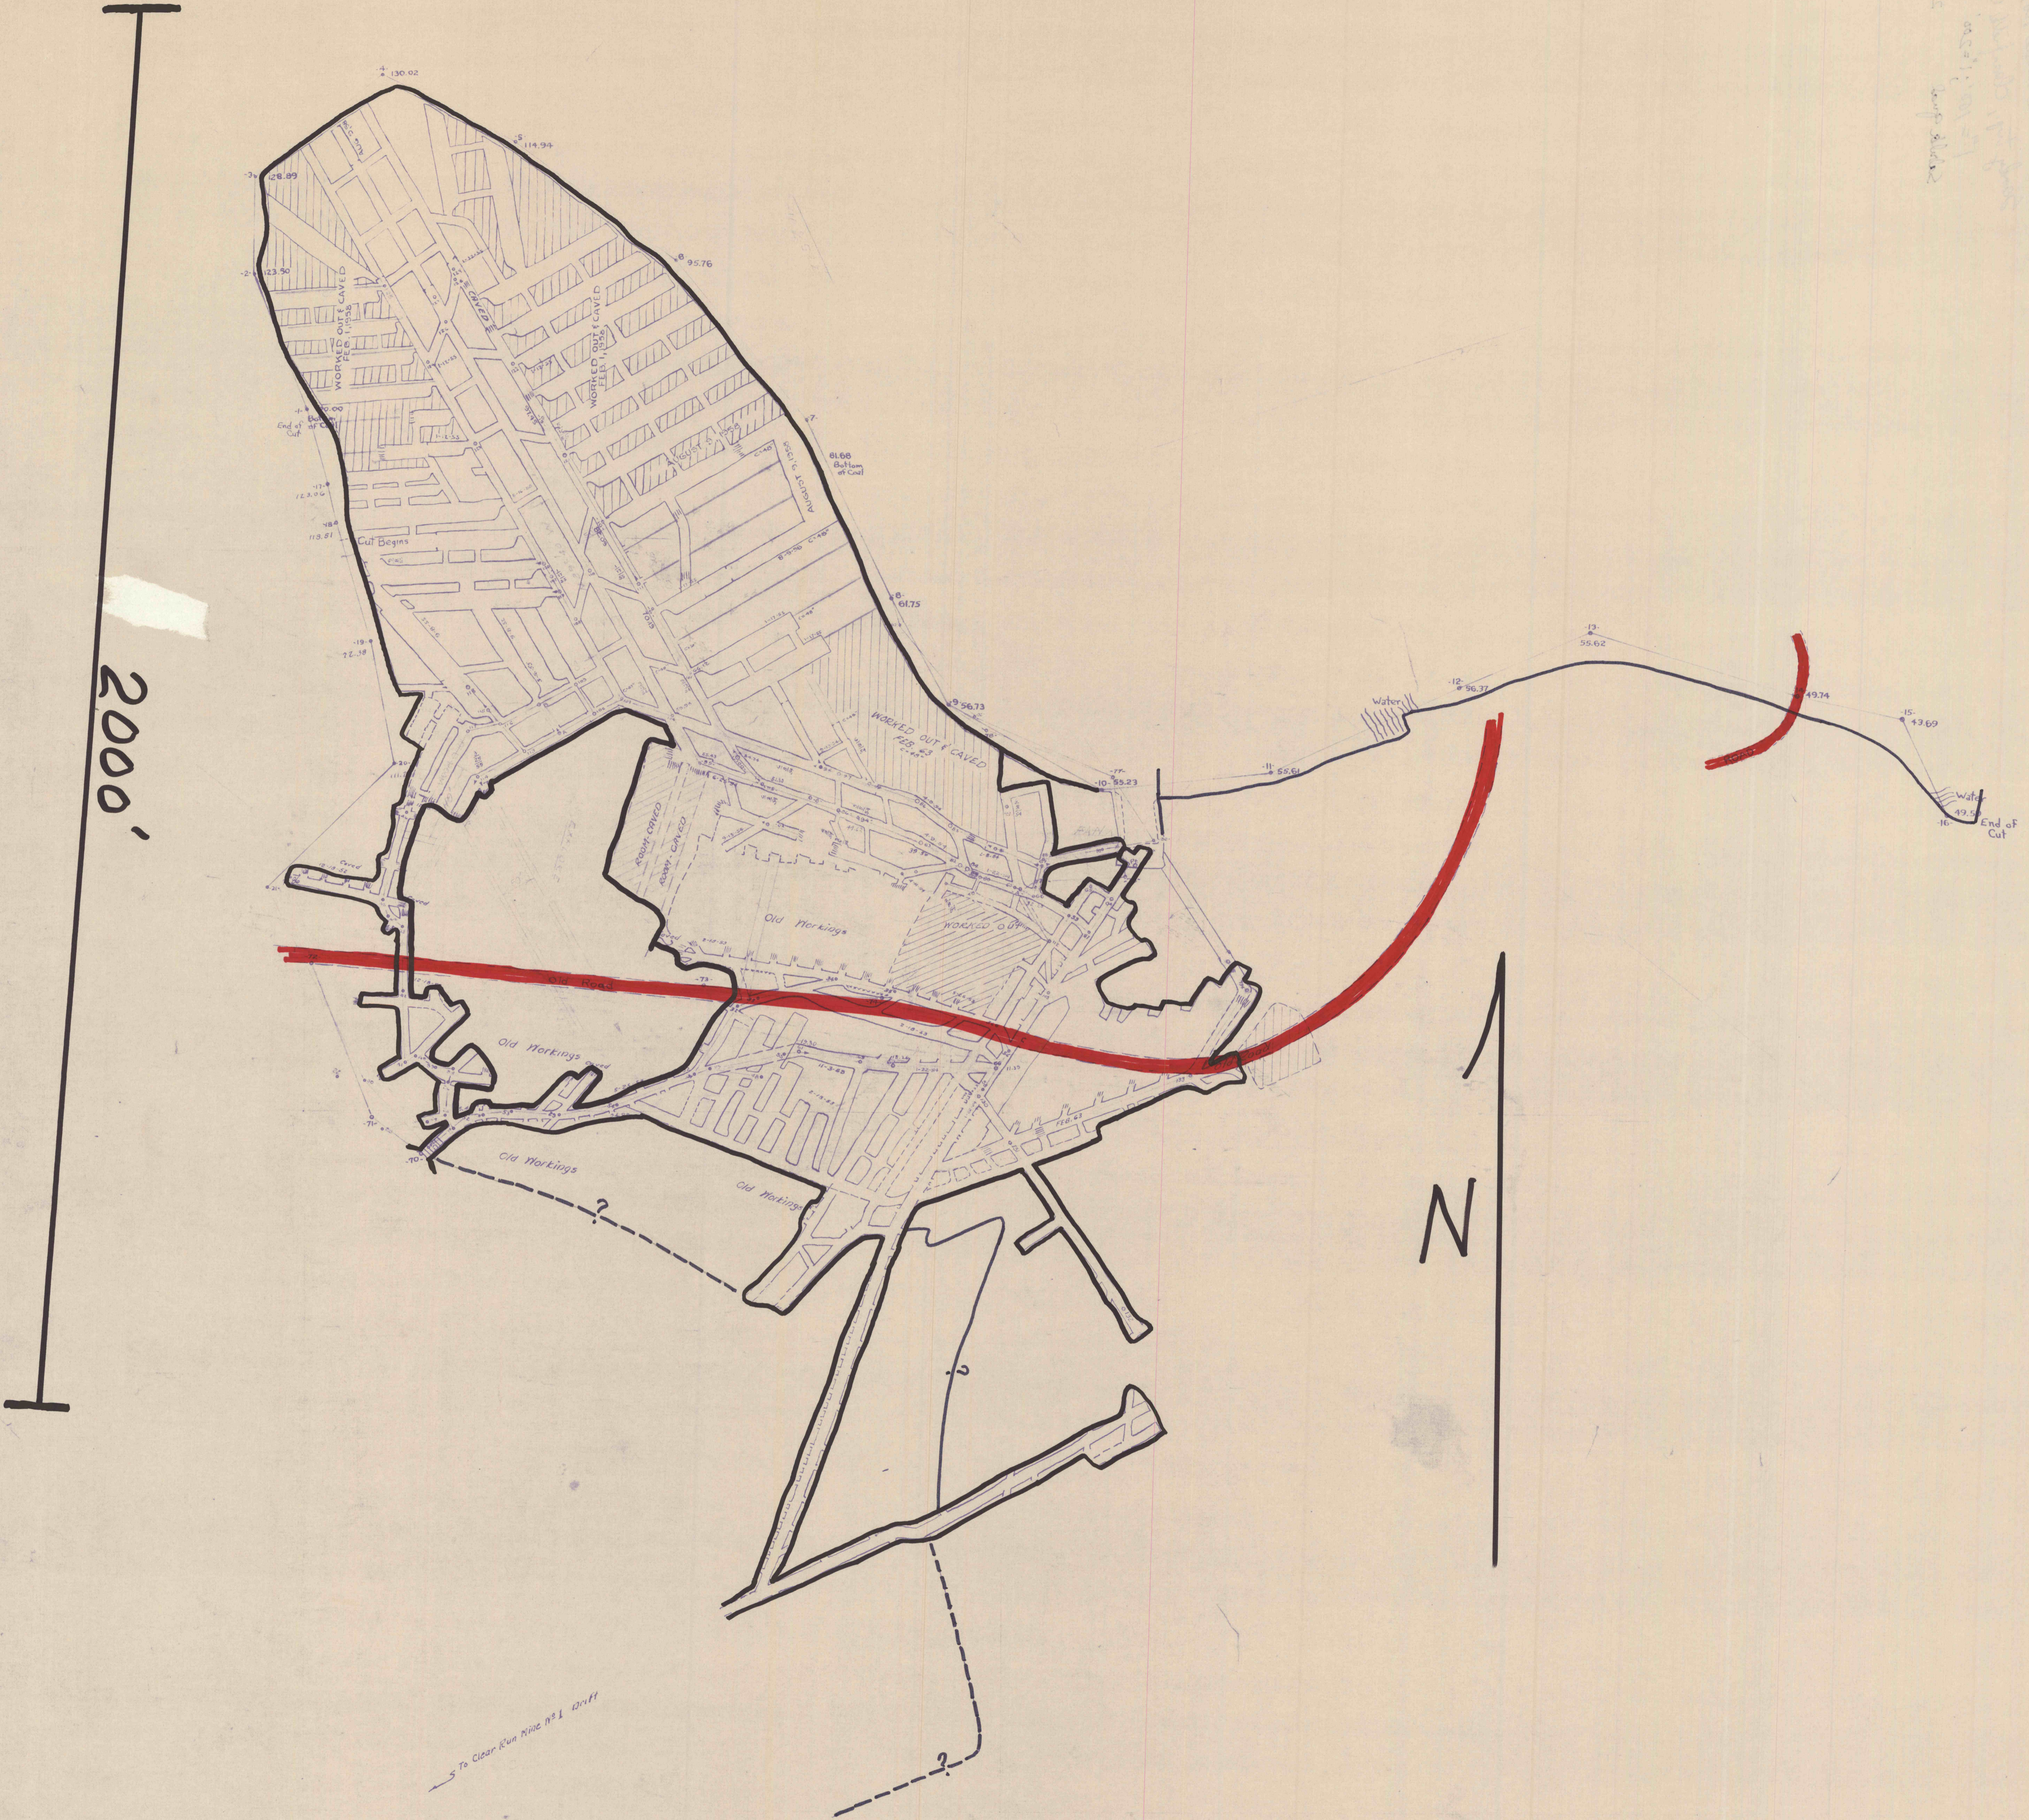

CLEAR RUN MINE No. 2
 SANDY TWP., CLEARFIELD COUNTY
 SCALE: 1"=100' 28 Nov. 1952

Semi Annual Survey Dates:
 5 May 1954
 Feb. 1, 1958
 Aug. 9, 1958
 Feb., 1963

SIMPSON & MADISON
 ENGINEERING OFFICE
 YOST, BROMFIELD & HESS
 DUBOIS, PA.