


Mapped by the Geological Survey  
1945

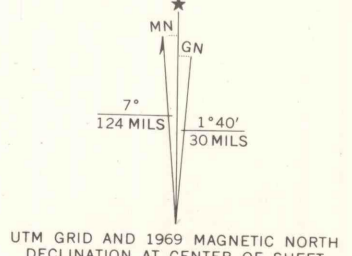


**ROAD CLASSIFICATION**  
Heavy-duty ——— 4 LANE 6 LANE Light-duty ———  
Medium-duty ——— 4 LANE 6 LANE Unimproved dirt ———  
U.S. Route      State Route



Revisions shown in purple compiled in cooperation with State of Pennsylvania agencies from aerial photographs taken 1969. This information not field checked.

FOR SALE BY U.S. GEOLOGICAL SURVEY, WASHINGTON, D. C. 20242  
A FOLDER DESCRIBING TOPOGRAPHIC MAPS AND SYMBOLS IS AVAILABLE ON REQUEST

ALLEMANS 2 MI.  
VAN ORMER 8.7 MI.  
TYRONE 11 MI.  
ALTOONA 31 MI.  
INTERIOR-GEOLOGICAL SURVEY, WASHINGTON, D. C. 1970  
POLYCONIC PROJECTION, 1927 NORTH AMERICAN DATUM  
5000 YARD GRID BASED ON U. S. ZONE SYSTEM, B  
10000 FOOT GRID BASED ON PENNSYLVANIA (NORTH)  
RECTANGULAR COORDINATE SYSTEM  
1000-METER UNIVERSAL TRANSVERSE MERCATOR GRID TICKS,  
ZONE 17, SHOWN IN BLUE

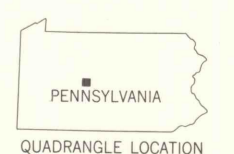

RAMEY, PA.  
LOWER KITTANNING (B)  
N4045-W7822.5/7.5

1945  
PHOTOREVISED 1969  
AMS 5365 IV SW-SERIES V831

CAMP HILL DISTRIBUTORS  
881 Market Street, Lebanon, Pa.  
717-264-1171

5207/2421

5195/2307

HOUTZDALE 1.3 MI.  
PHILIPSBURG 11 MI.

HOUTZDALE 1.3 MI.  
OSCEOLA MILLS 7 MI.


4707/2245

4712/2458

4652/2306





