


57

SCALE - 1" = 1800'

1" = 1800'

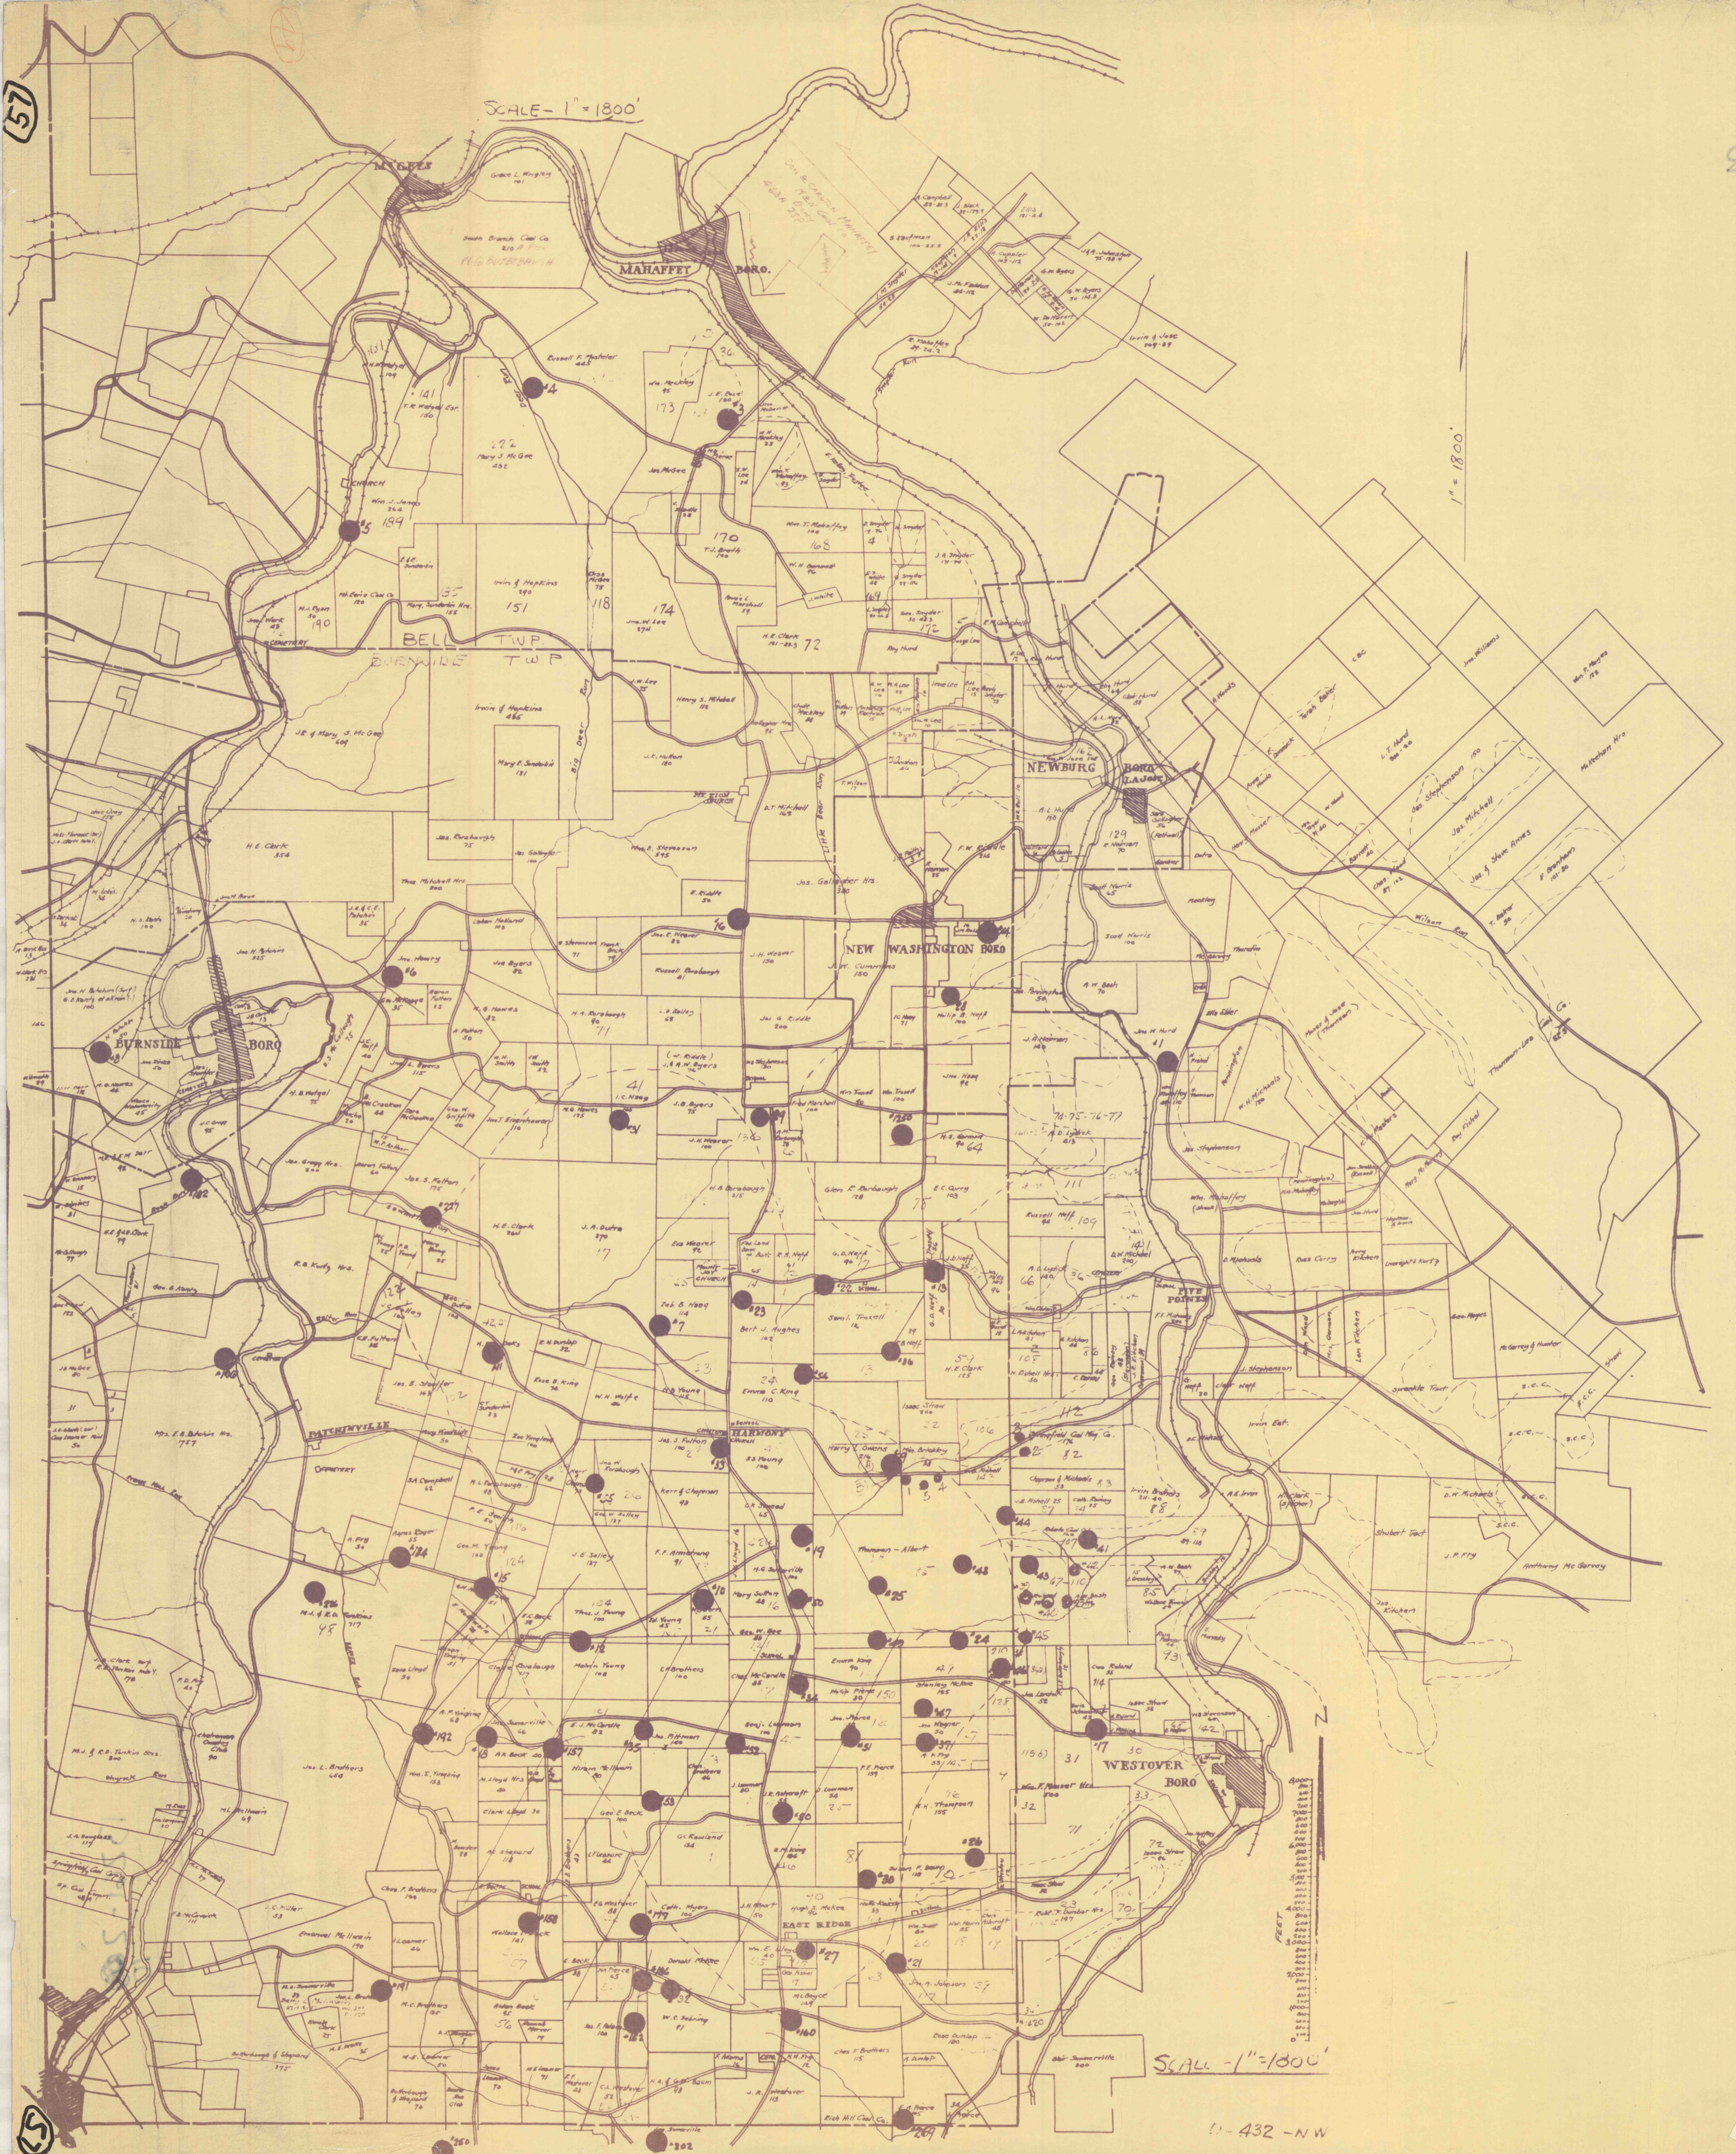

SCALE - 1" = 1800'

432 - NW