


41-315



MAP SHOWING LANDS OF S. HEGARTY SONS AND 'D SEAM DEEP MINE OPERATIONS OF J.E. LEYO AND CAMBRIA MILLS COAL CO., APPLE #4 MINE BECCARIA TWP, CLEARFIELD CO., PENNA. SEPT. 21, 1959. J.L. BANFIELD REG. ENG.


REVISIONS	
1	JAN 1 - 1967
2	JULY 25 1967
3	JAN. 18 - 1968
4	JULY 31, 1968
5	FEB. 12, 1967
6	AUG. 4, 1967

MAP REVISED AS OF RECENT SURVEY 1968

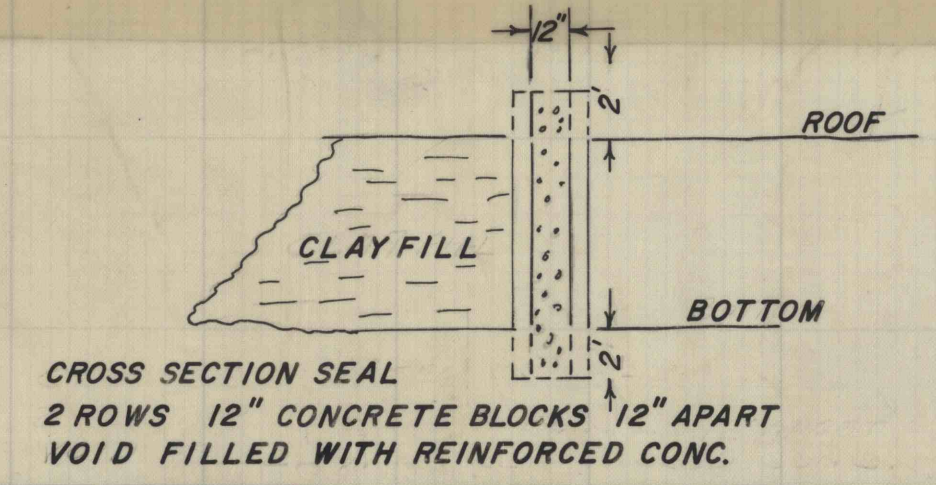

NOTE: COMPLETE MINING RIGHTS FOR ALL COAL HELD BY CAMBRIA MILLS COAL CO. INC.

2-1-70

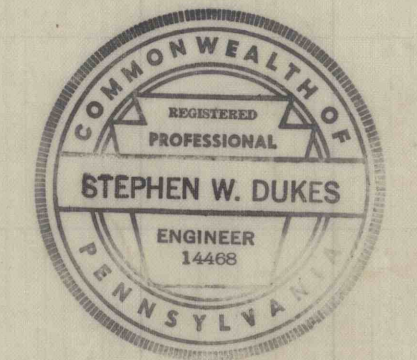

PROPERTY MAP
 CAMBRIA MILLS COAL CO. INC.
 SITUATE
 BECCARIA TWP, CLEARFIELD CO., PA
 JULY 14, 1966

SCALE 1" = 200'	GWIN ENGINEERS, INC. CONSULTING ENGINEERS ALTOONA PENNSYLVANIA	SHEET NO. PR 7904-1264
--------------------	----------------------------------------------------------------------	---------------------------

Coalport 7 1/2 66-6-60