
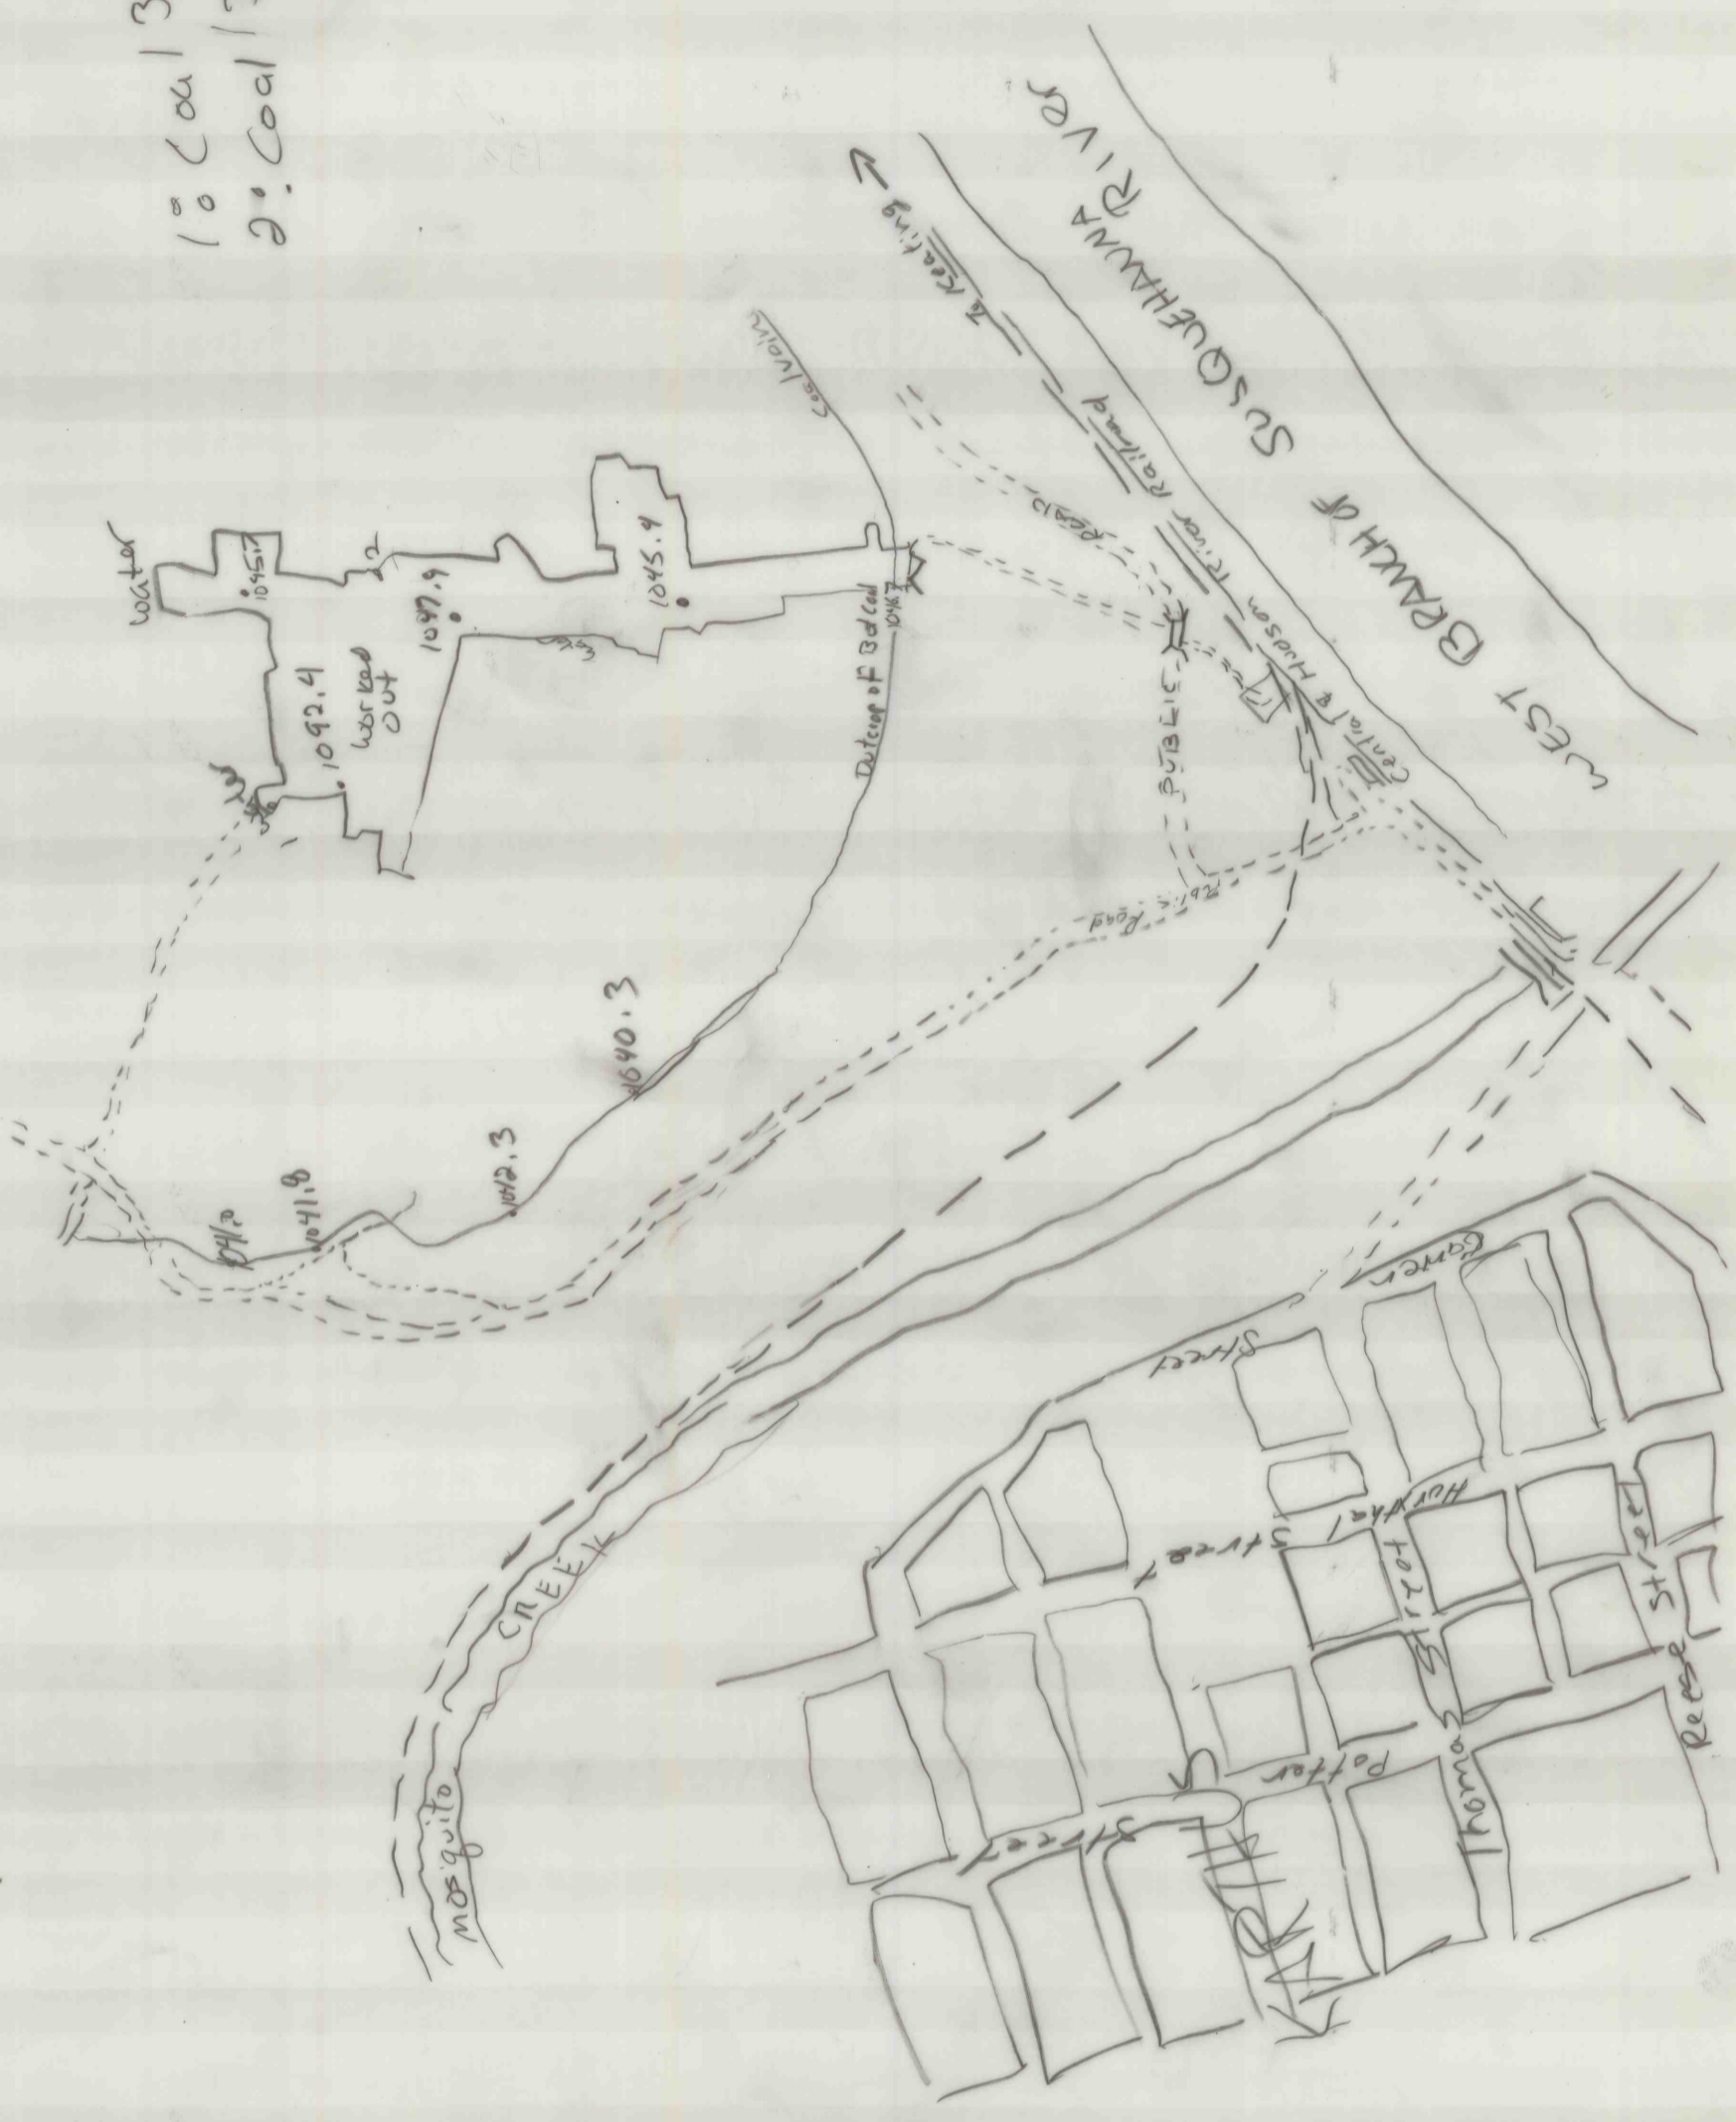


1st Coal 13'4"
 2nd Coal 13'0"

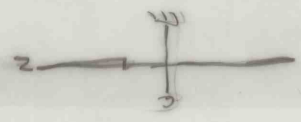

Karthaus Estate
 (Portion) map of the "Stage"
 coal mine
 Karthaus.