


(1 = 50')

"C" Prime Mine
Edward D. Smith
Karthaus Twp

John & William D. Ash

ROY HOFFMAN
Philip Reese

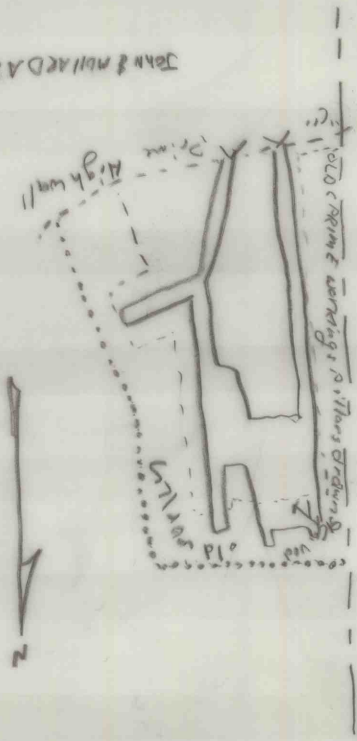

m.p. of J.W. Potter Tract
Karthaus Twp

(1 = 400')

