

map of C & D  
Seam Strippings  
John E. Teeter  
Karthaus Twp.


1: SE 1380.97  
TC 1306.97  
2: SE 1320.94  
TC 1296.94

3: SE 1320.33  
TC 1303.33

5: SE 1465.06  
TC 1389.06

56: SE 1324.65  
TC 1236.65

(1-200)

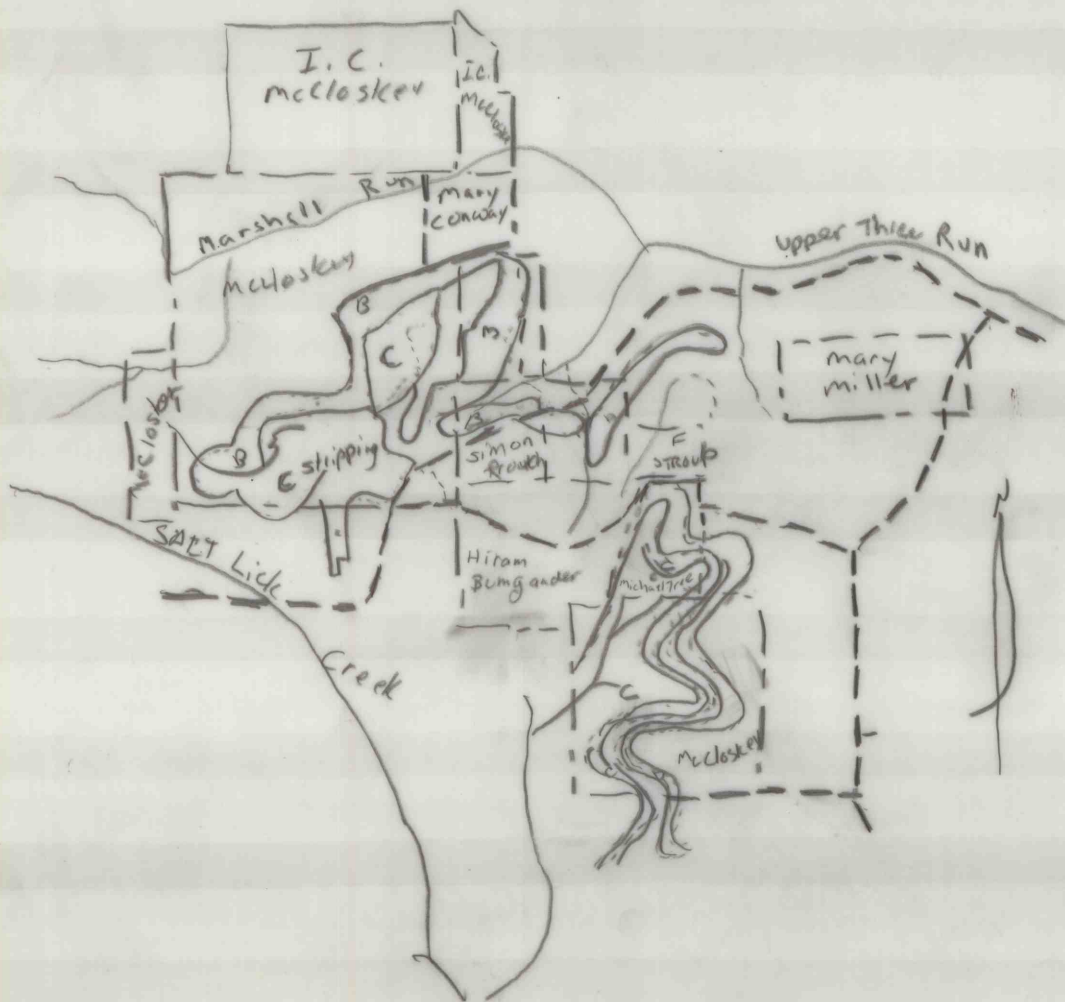

Harold Boulton  
Karthaus Twp. Properties

1" = 660'