


Map showing "C" Prime
and "D" Seam stripping
Johr & Teeter
Karthaus Twp

7.5E 1393.03
 8. SE 1356.92
 TCDE 1349.92
 TCCE 1308.42
 9. SE 1321.49
 TCDE 1306.43
 TCCE 1284.0

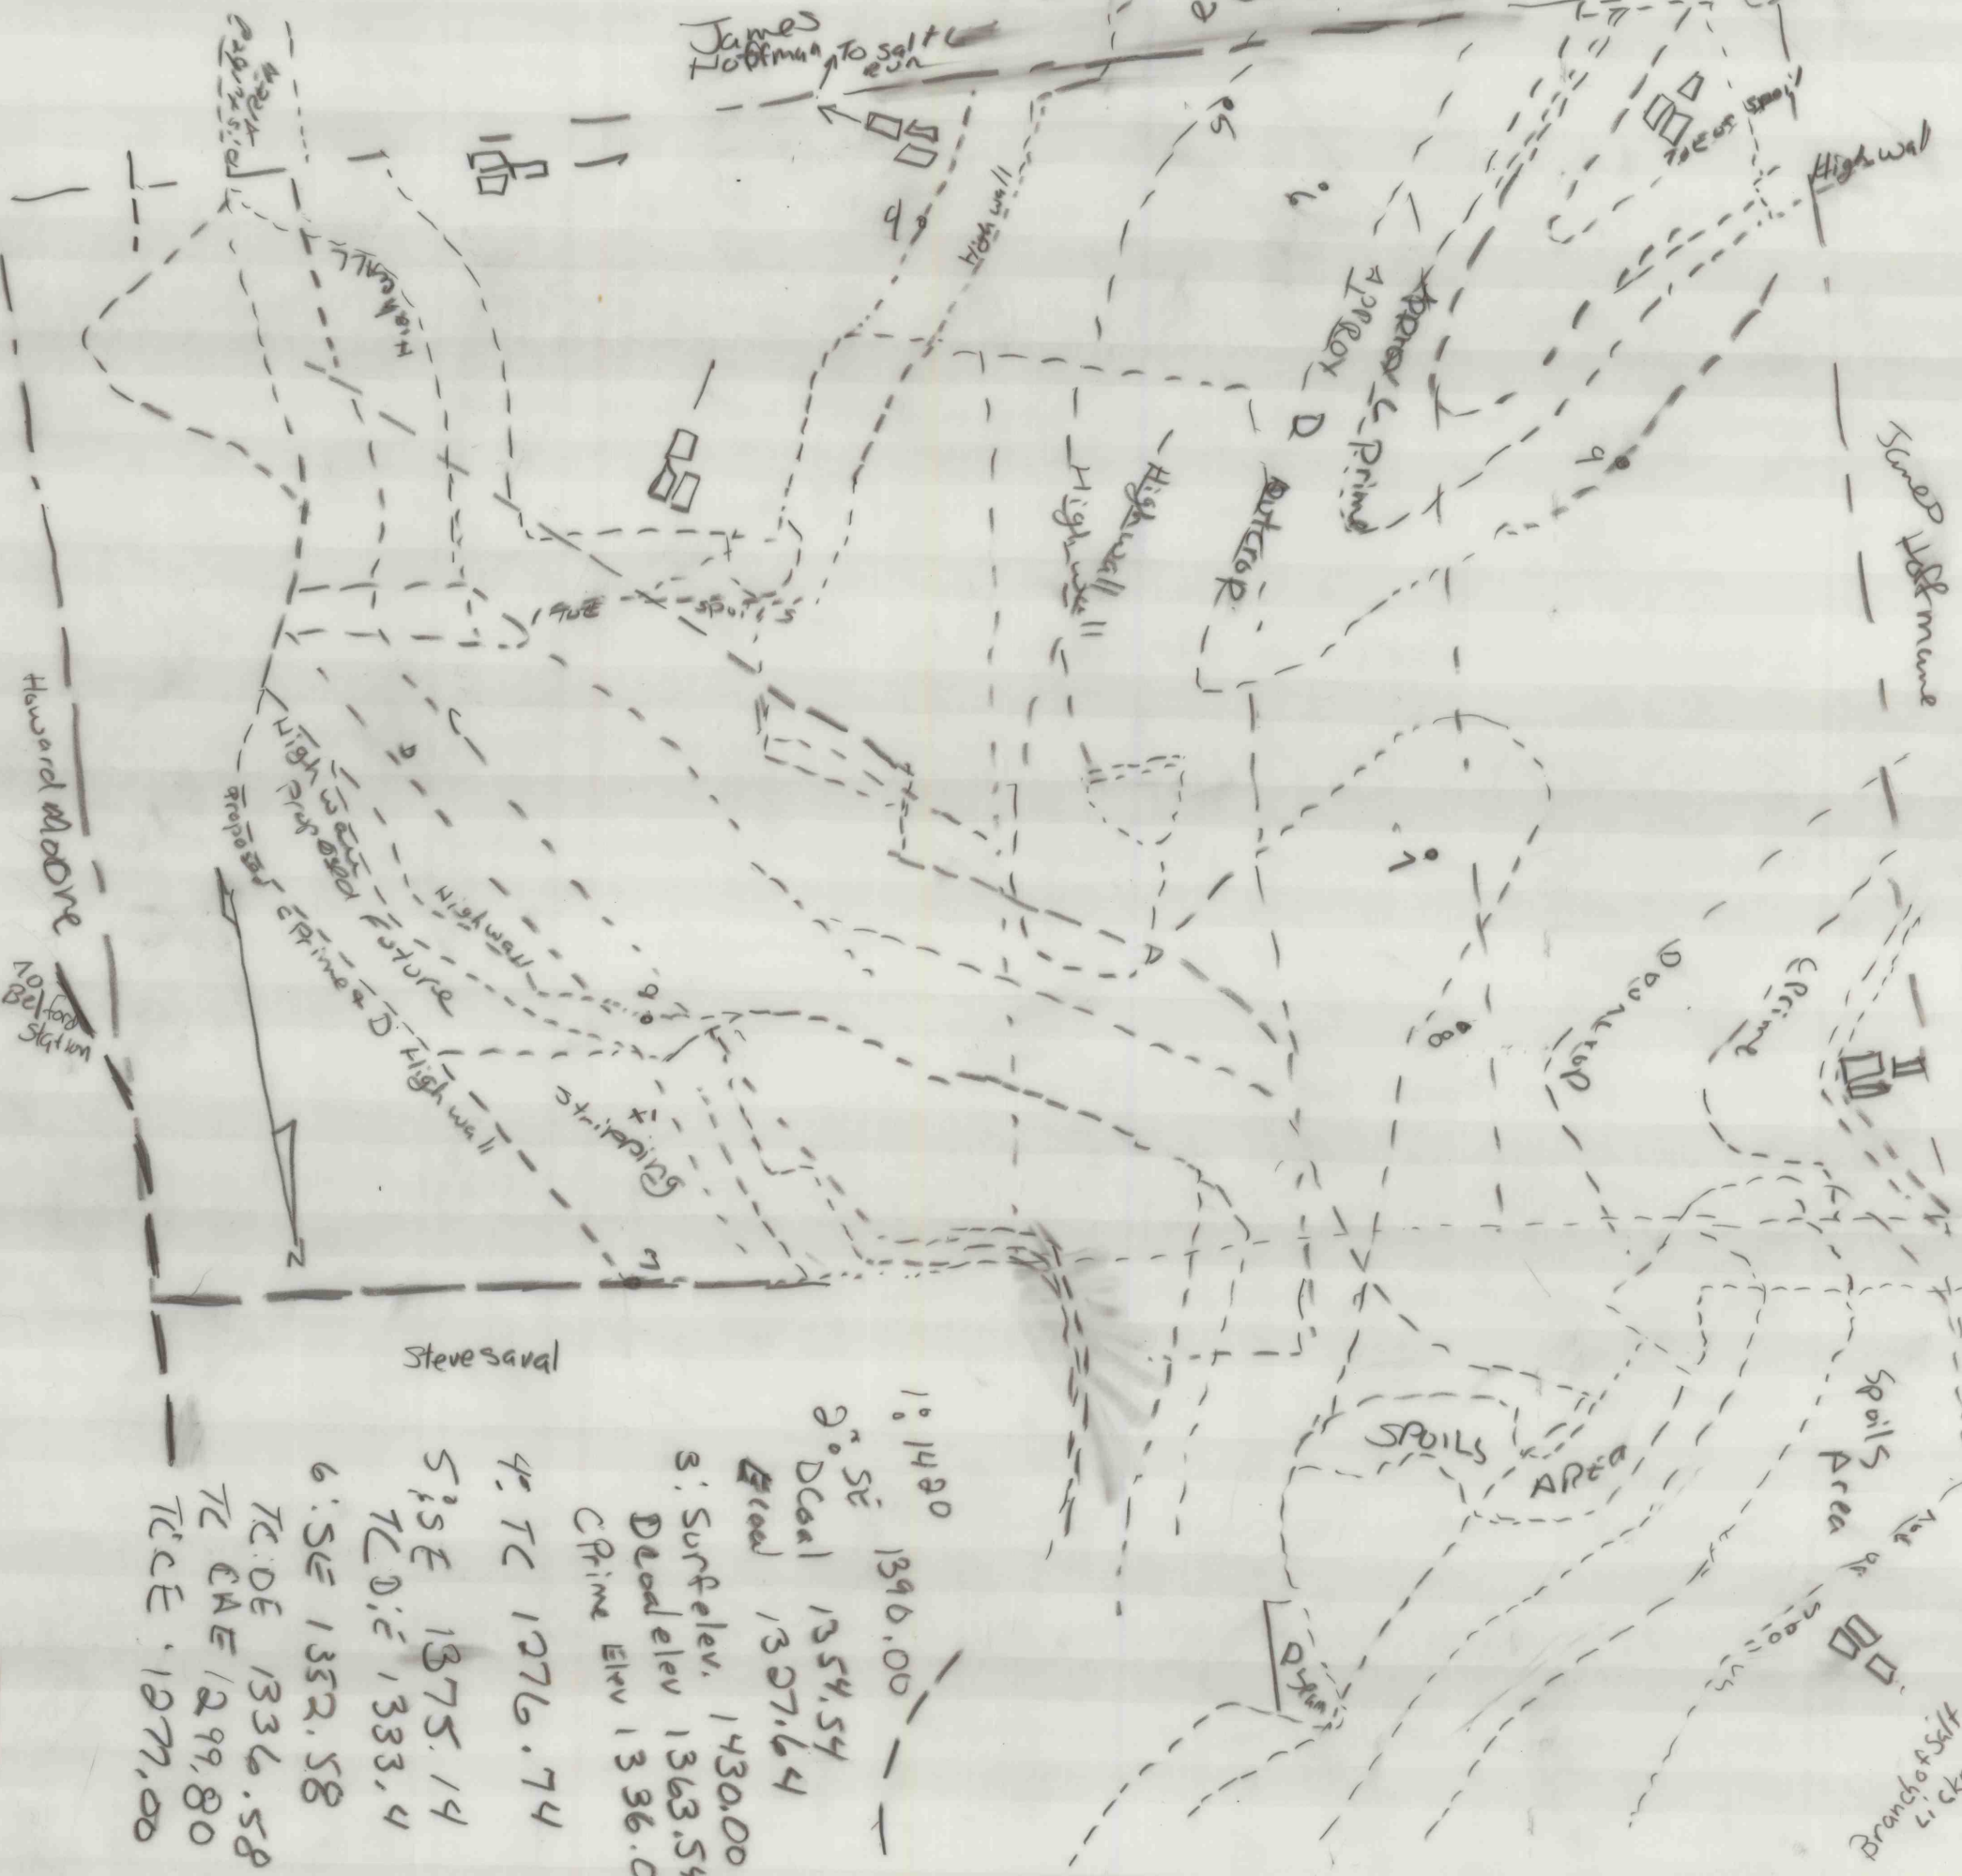

10. 14.90 1390.00
 9. SE 1354.54
 DeaL 1327.64
 3. Surf elev. 1430.00
 Dead elev 1363.54
 C Prime Elev 1336.00
 4. TC 1276.74
 5. SE 1375.14
 TCDE 1333.4
 6. SE 1352.58
 TCDE 1336.58
 TCCE 1299.80
 TCCE 1277.00