


G W Smeal  
1837.75

Fairview  
v. B.  
Church

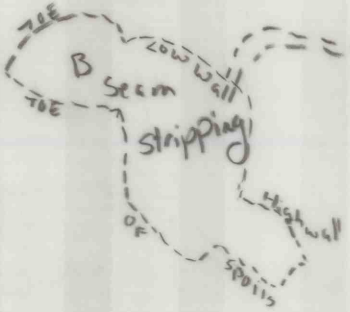

John, Jacob & Sarah  
Lytle

STIPPING ROAD

STEINER TRACT

FLEGAL TRACT

Map showing "B"  
seam stripping  
Thompson Coal Co,  
Graham Twp.

G W Smeal  
1837.20  
Breckenridge Co. A