


Portion of T.H. Forcey
 Estate + coal parcels
 Kristianson & Johnson
 Graham Twp.
 (1-400)

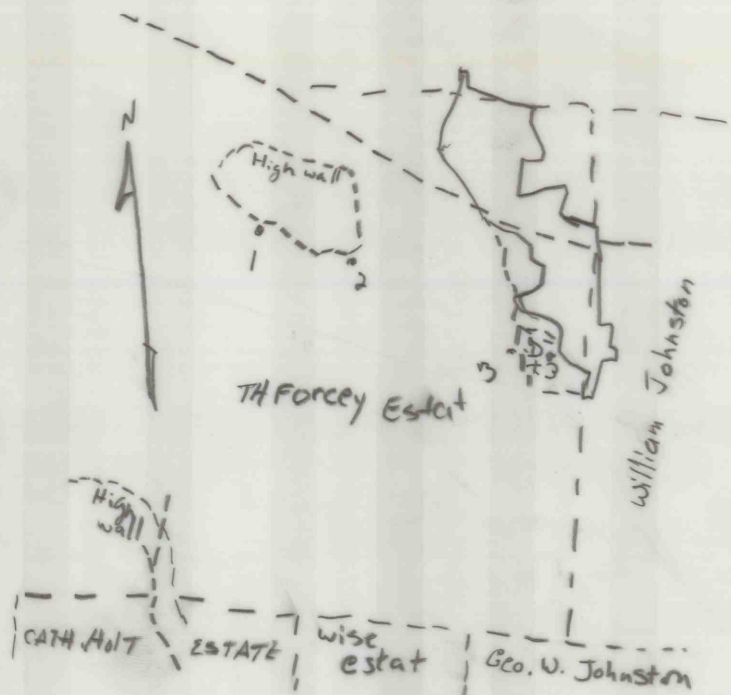

- 1. N 74° 00 W
165.00
- 2. S 35° 15 W
125.0
- 3. N 6° 15 E
442.00