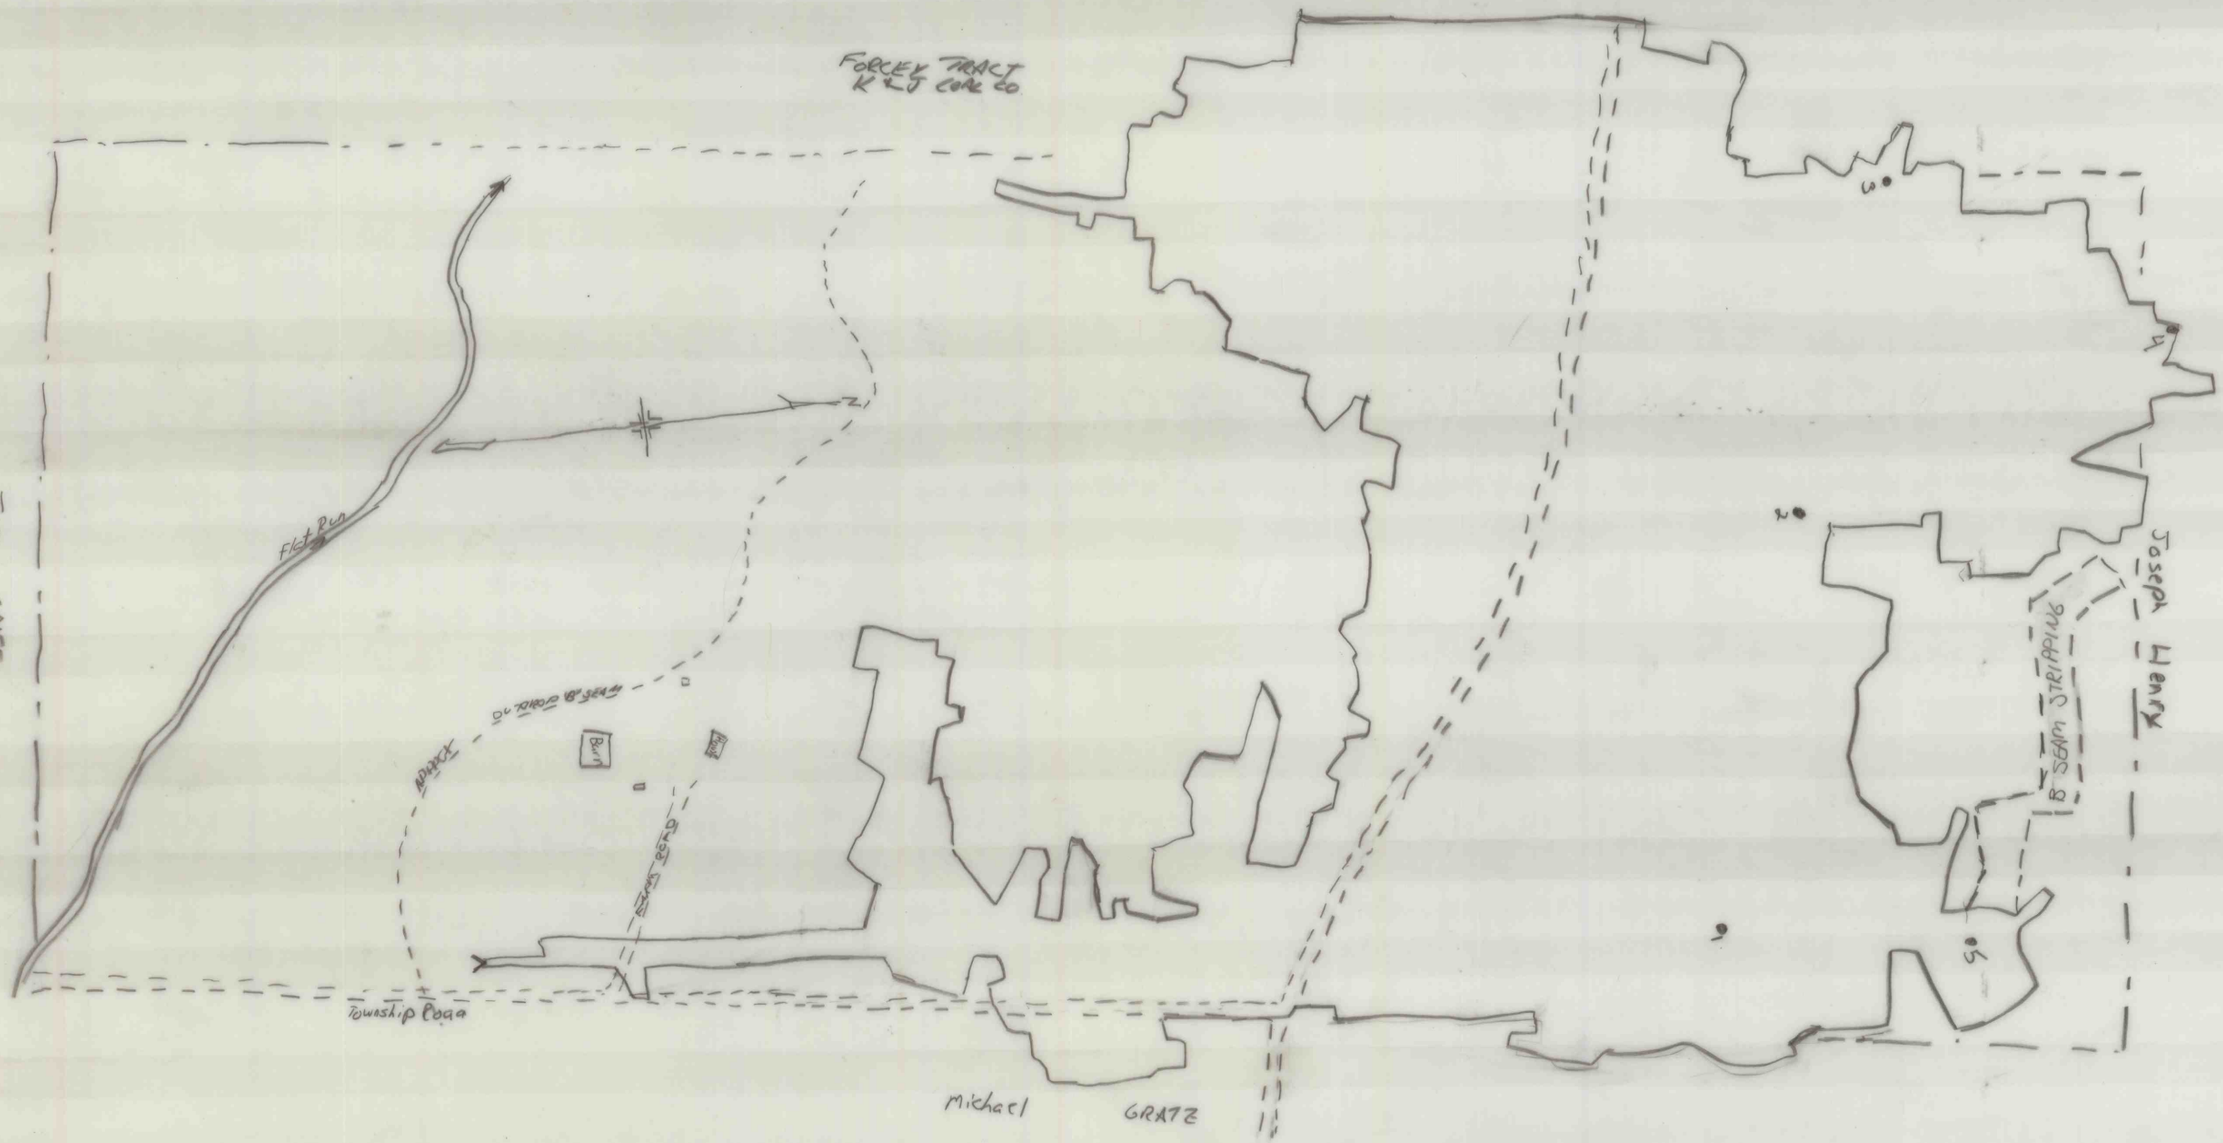

Flat Run No. 1 Mine
Graham Twp.