

E. & E. SUNDERLAND

T. SUNDERLAND


JOS. WORK Est.

H. SUNDERLAND

4000.0 East

3000.0 North

NEW YORK CENTRAL RAILROAD

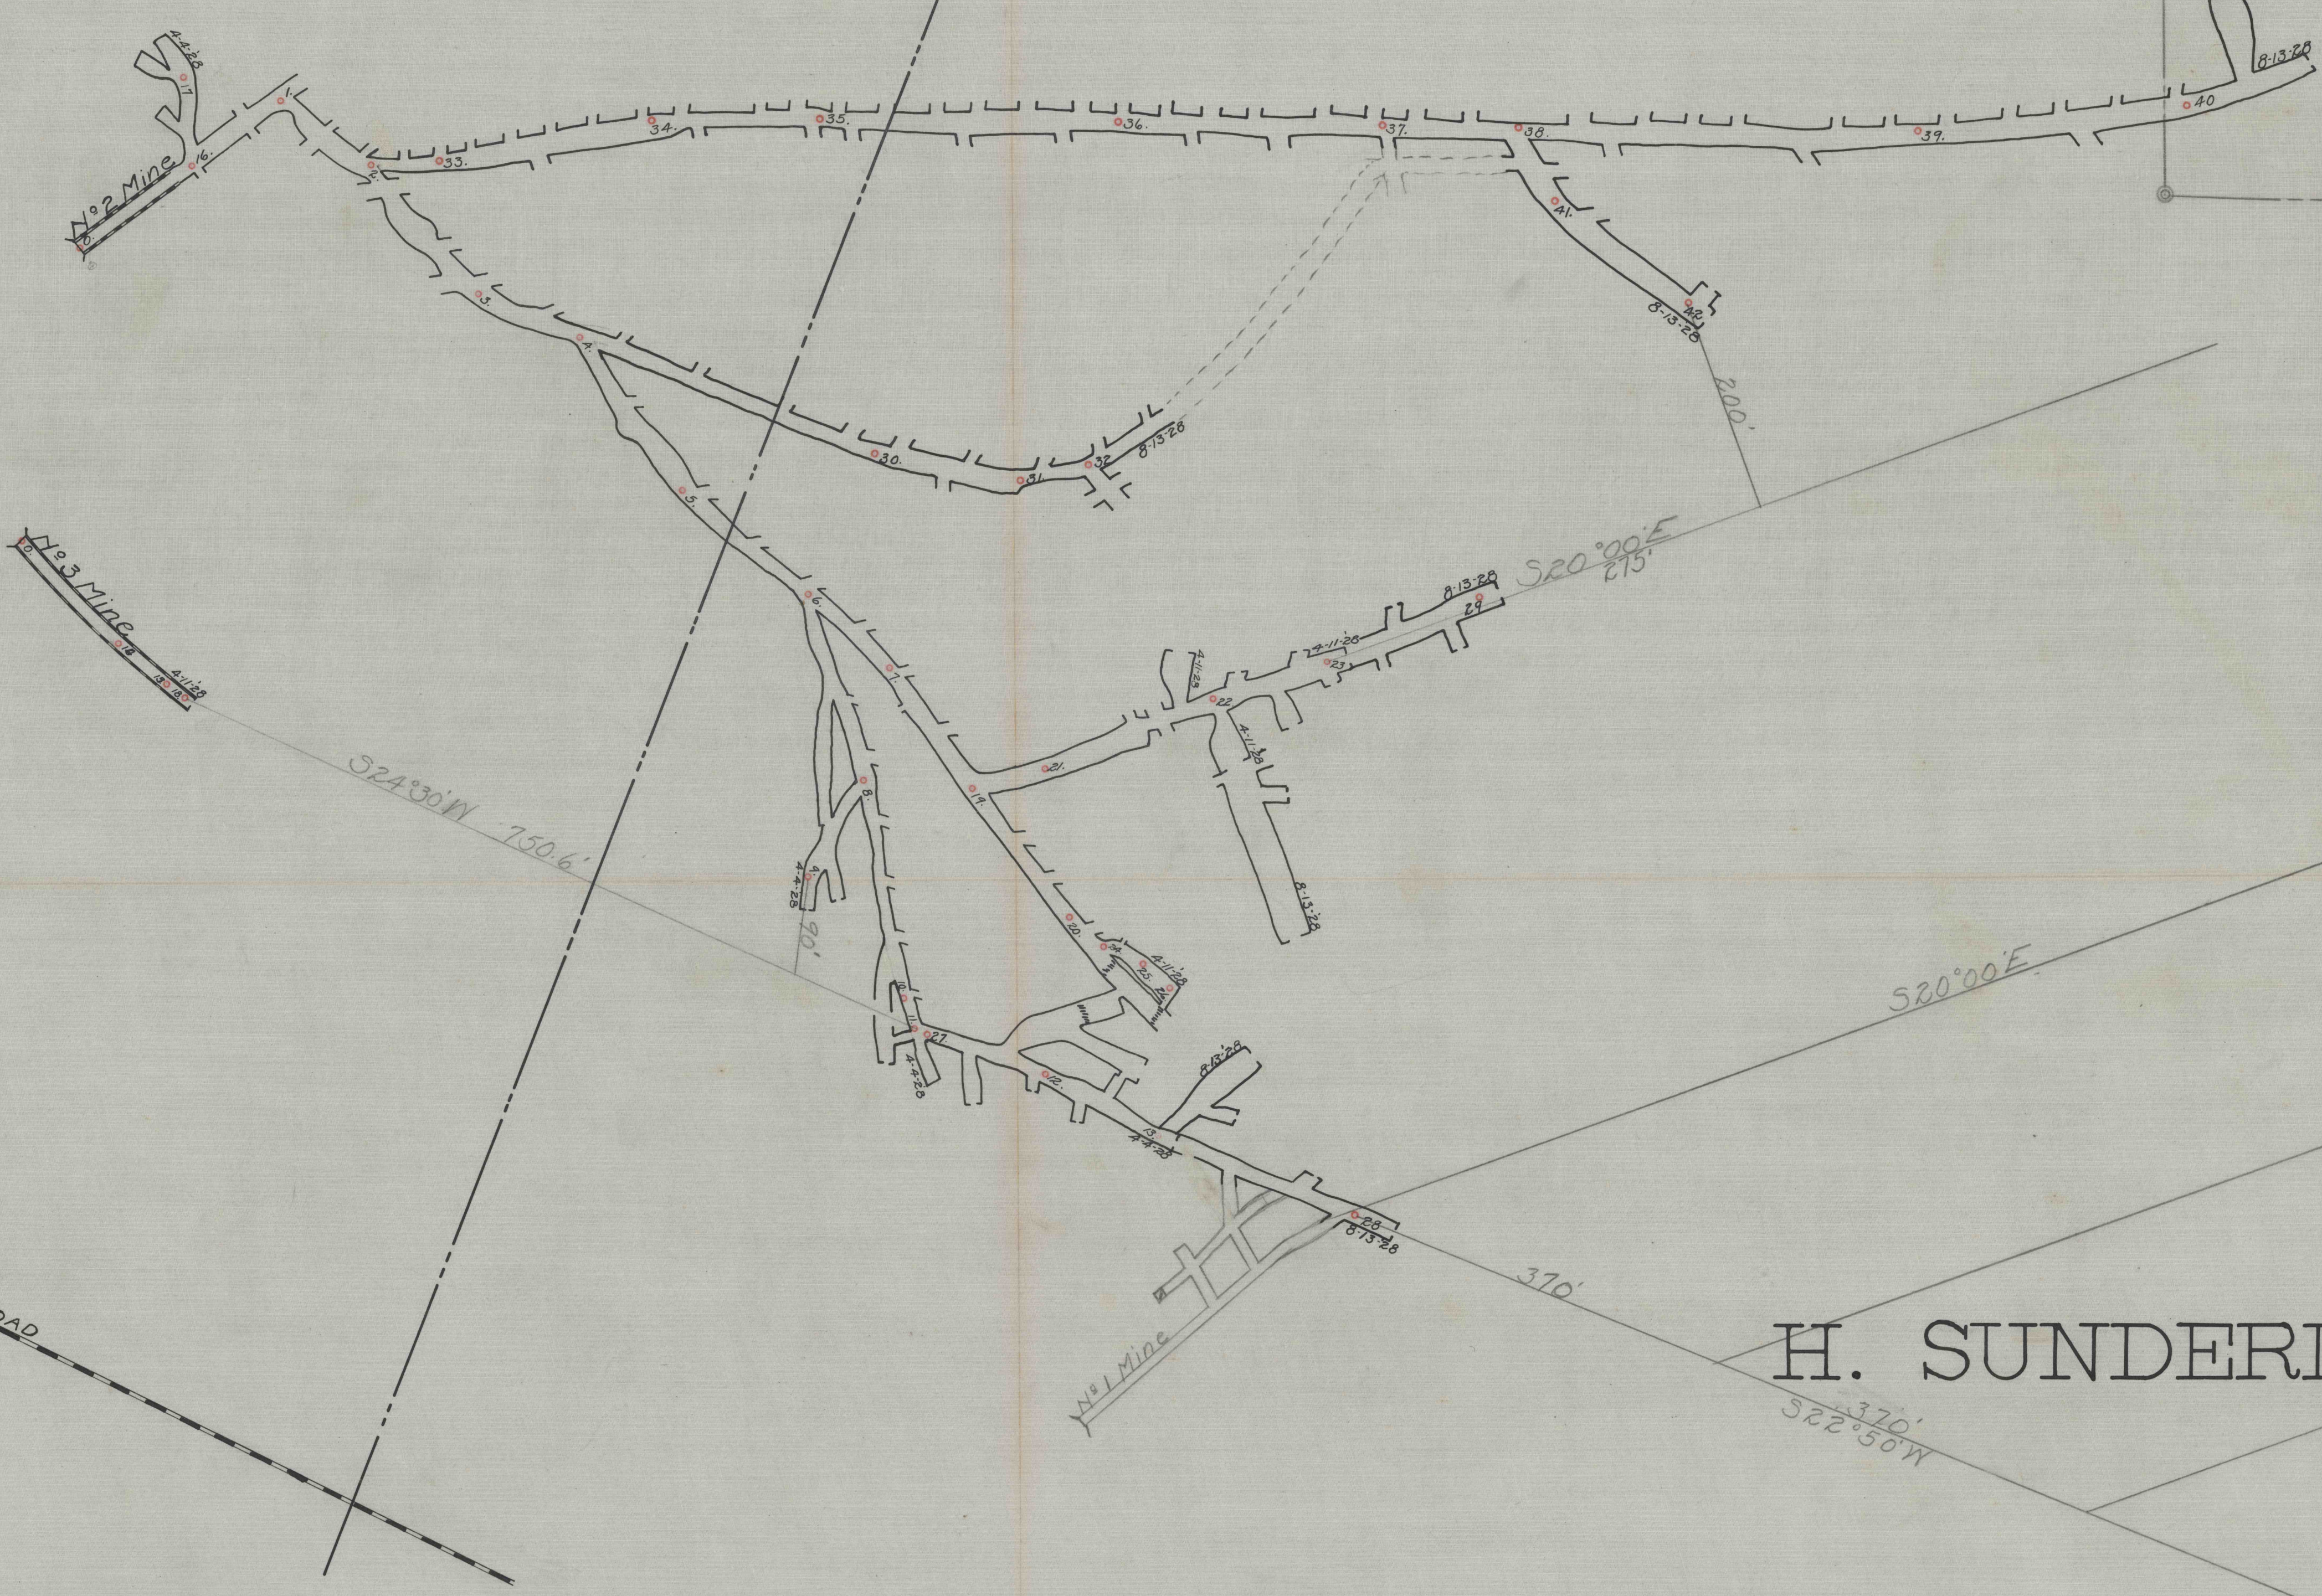

**MAP  
OF  
MOUNT AIRRIE MINE**

BELL TOWNSHIP,  
CLEARFIELD COUNTY, PA.

SCALE 1"=100'

PUNXSUTAWNEY, PA.  
APRIL 12, 1928.

HALE A. GUSS,  
ENGINEER.

