


22



1000.0 North

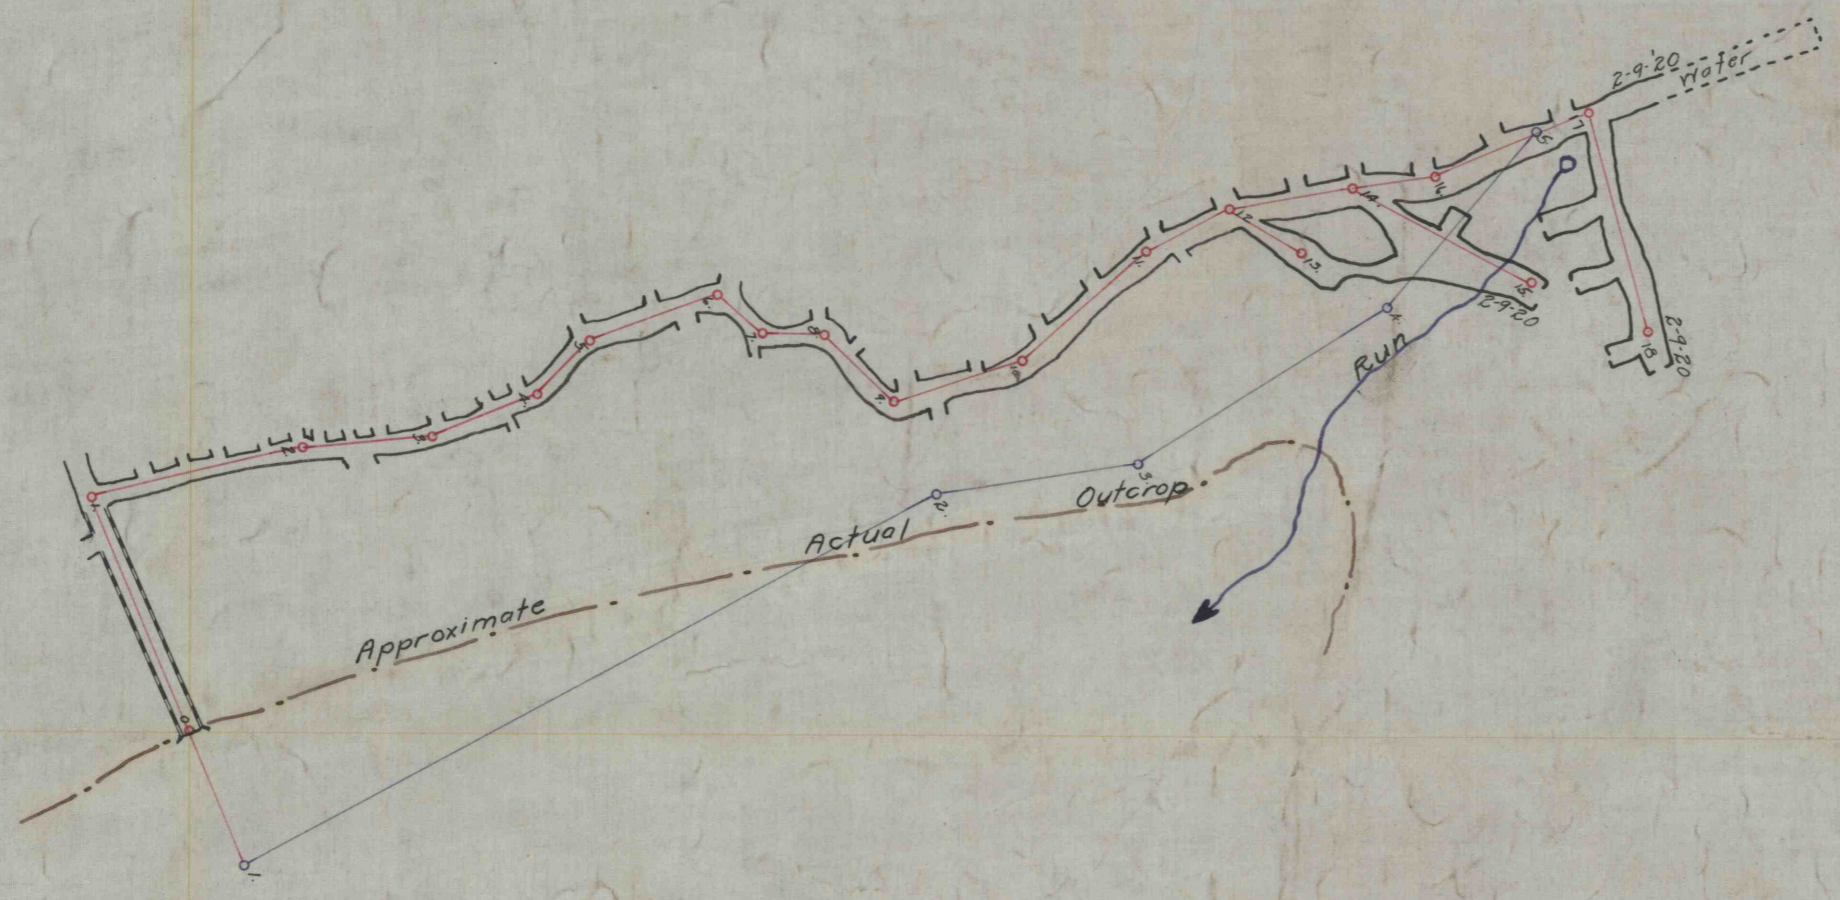

R.C. MAHAFFEY MINE

Situate near

Mahaffey, Clearfield, Co., Pa.

Scale 1"=100'

Feb. 12, 1920.

H.M. Kanarr Eng'r.
Punxsutanney, Pa.

1000.0 East

2000.0 East

A
22