

JOHN LONG

CHARLES STYERS

ESTHER MCGEE ESTATE


LULU V. WEBER

Mined Prior to
March 8, 1962

Mined Prior to
March 8, 1962

Mined Prior to
May 7, 1958

DATE OF SURVEY
May 7, 1958
March 8, 1962

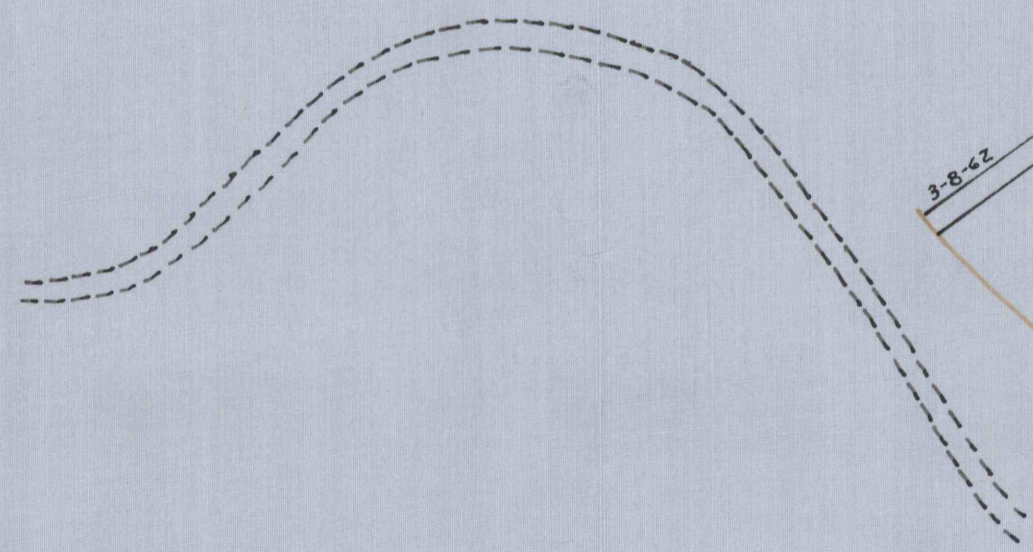

Iron Pipe

LULU V. WEBER

Highwall



MINE MAP

WILLIAM M. MAURER

COAL MINE

BELL TOWNSHIP, CLEARFIELD COUNTY, PA.

SCALE 1"=100'

MAY 7, 1958

WALTER J ZIMMERMAN SURVEYOR PUNXSUTAWNEY, PA

LUL

15-31

