


GEO. M. YOUNG
124

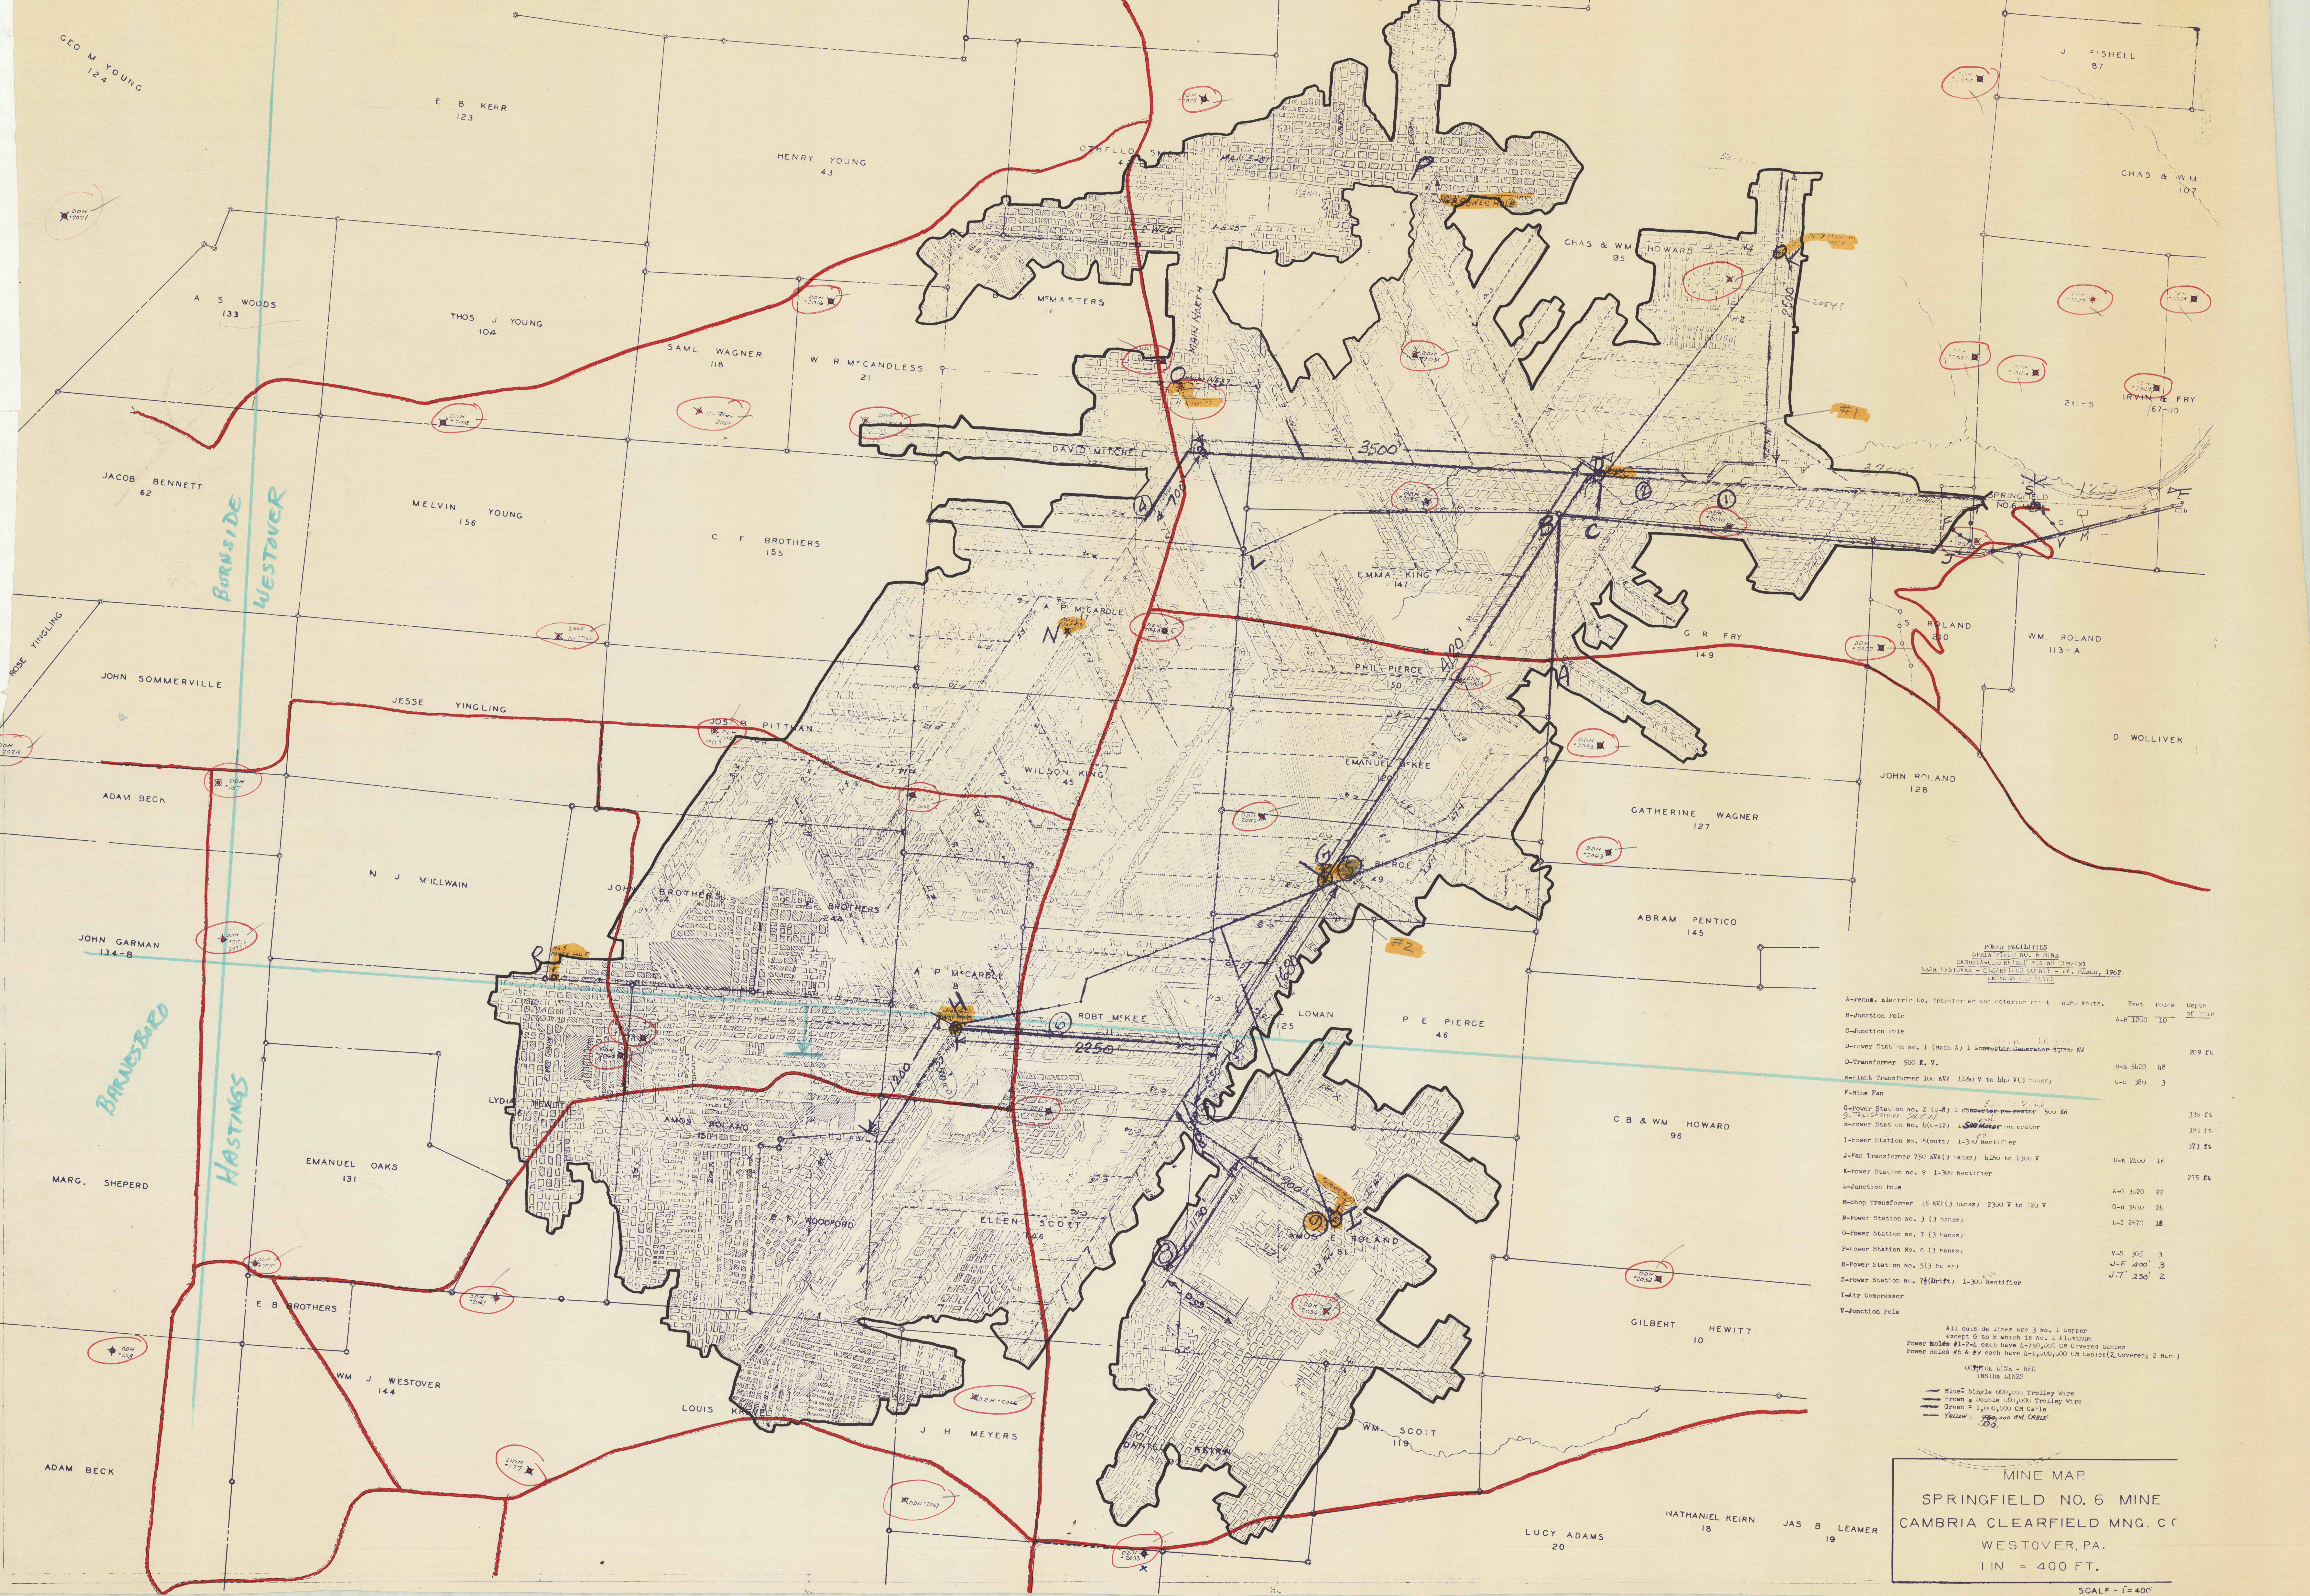

SPRINGFIELD NO. 6 MINE
CAMBRIA CLEARFIELD MNG. CO.
WESTOVER, PA.

Letter	Description	Feet	Volts	Depth

All outside lines are 3 No. 1 Copper
except 9 to 11 which is No. 1 Aluminum

OUTSIDE LINES - RED
INSIDE LINES

MINE MAP
SPRINGFIELD NO. 6 MINE
CAMBRIA CLEARFIELD MNG. CO.
WESTOVER, PA.
1 IN = 400 FT.