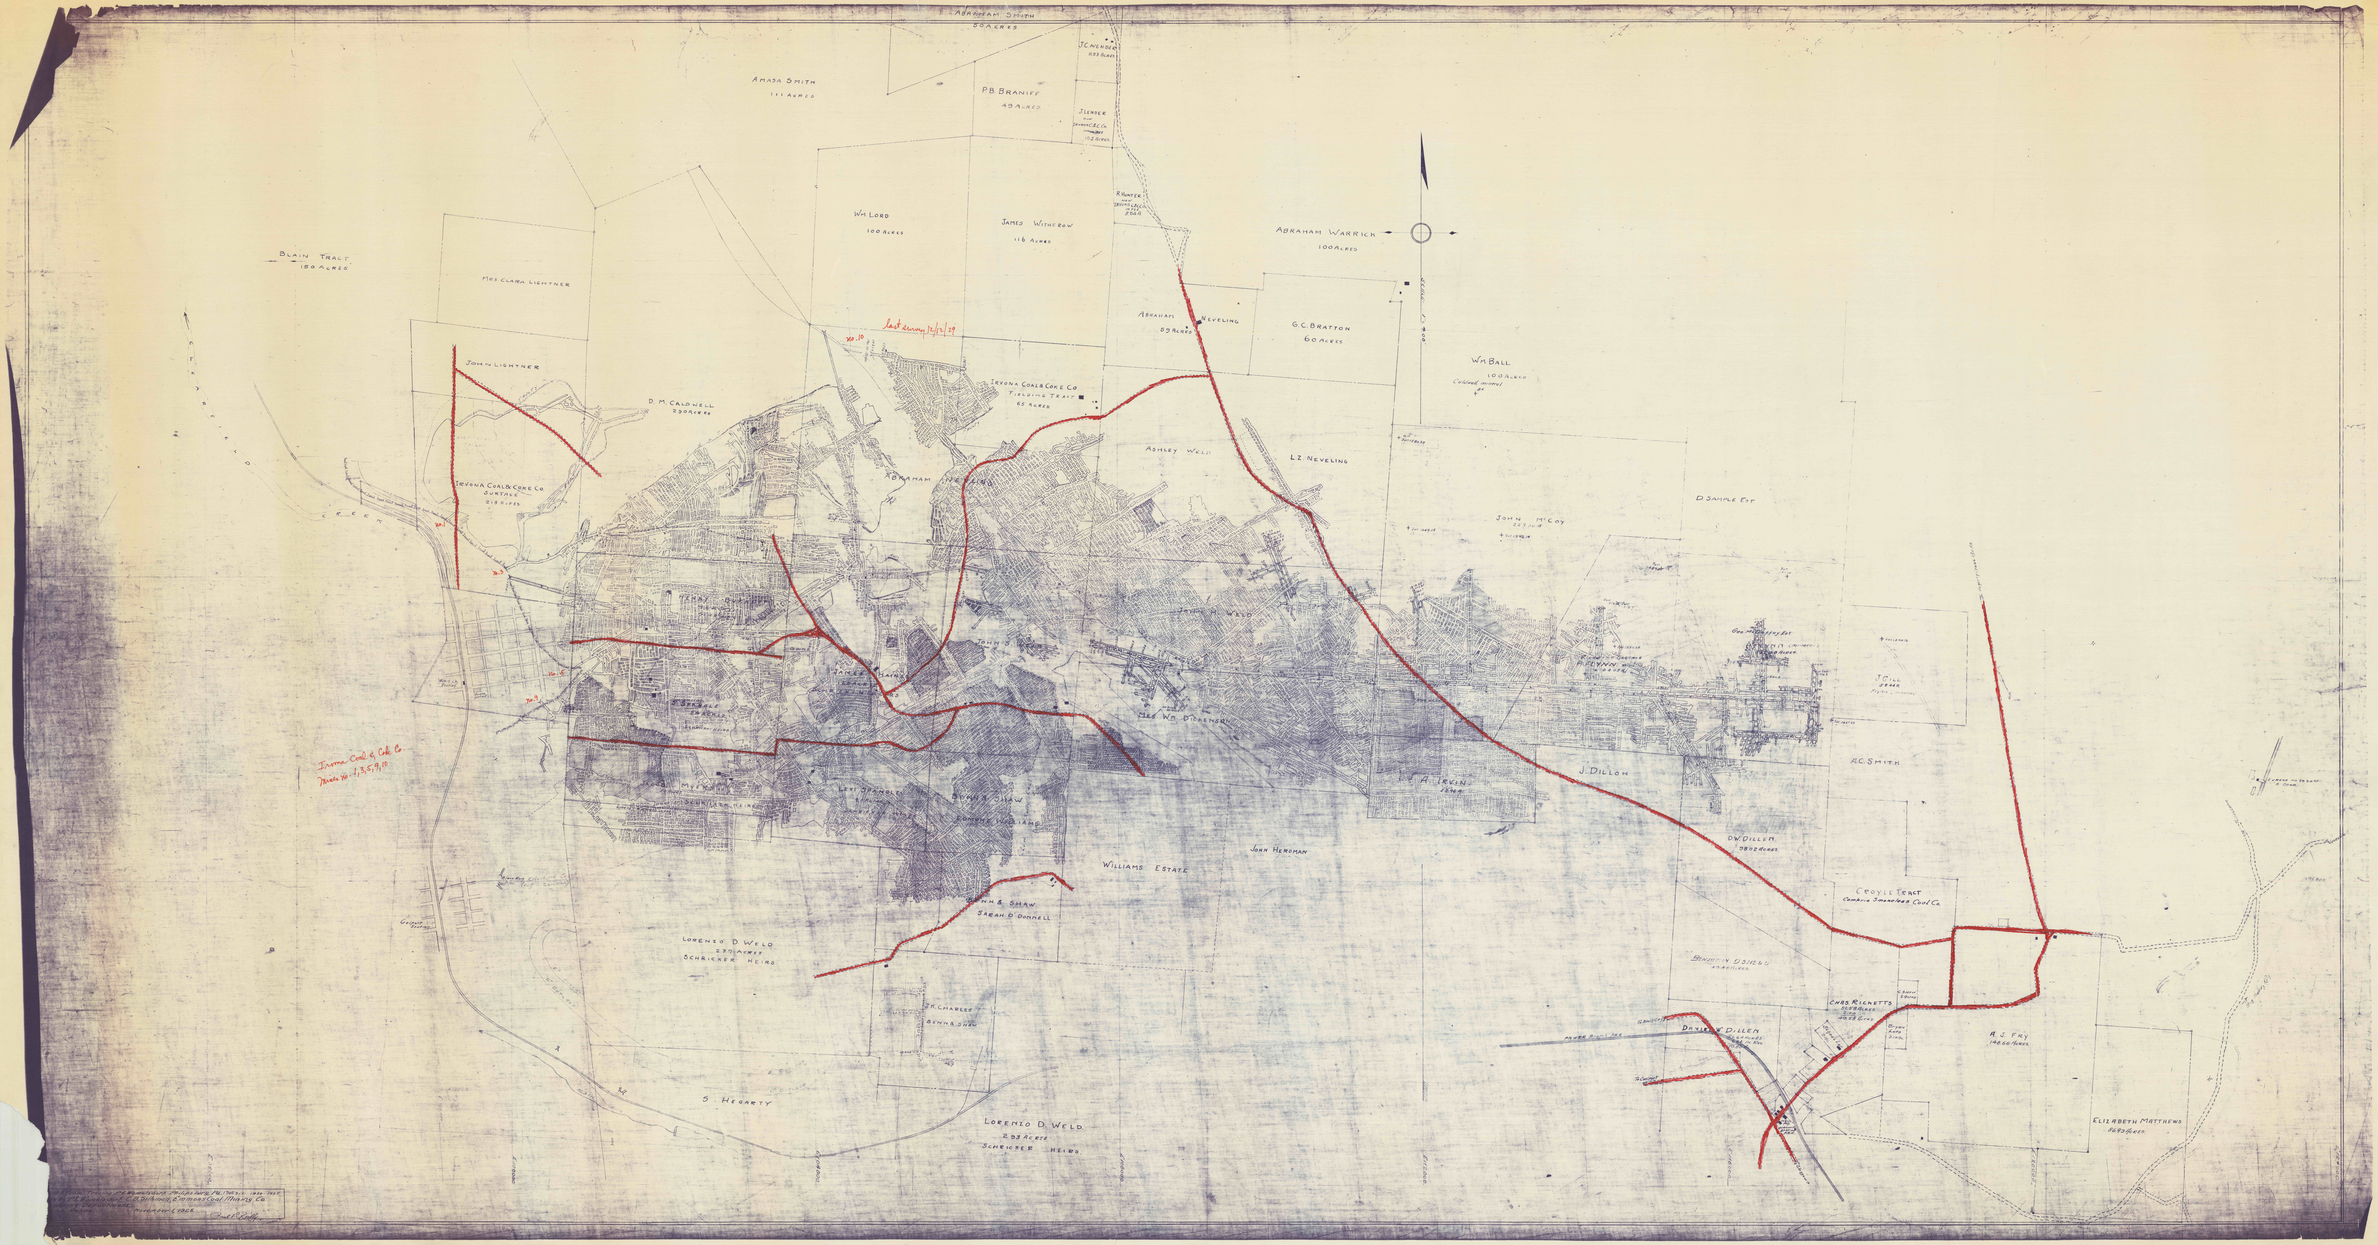

Abraham Smith
50 Acres
Amasa Smith
111 Acres
P.B. Braniff
49 Acres
J.C. Wender
J. Lesser
Wm Lord
100 Acres
James Witherow
116 Acres
Abraham Warrick
100 Acres
Blain Tract
150 Acres
Mrs Clara Lightner
Abraham Neveling
59 Acres
G.C. Bratton
60 Acres
Wm Ball
100 Acres
Last survey 12/12/29
John Lightner
D.M. Caldwell
230 Acres
Irvona Coal & Coke Co
Tielding Tract
65 Acres
Ashley Weld
L.Z. Neveling
Irvona Coal & Coke Co
Surface
218 Acres
Abraham Neveling
John McCoy
D. Sample Est
Mrs Wm Dickenson
J. Dillon
A.C. Smith
Irvona Coal & Coke Co
Mines No. 1, 3, 5, 7, 9, 10
Levi Spangler
Benn & Shaw
Williams Estate
John Heroman
D.W. Dillen
Croyle Tract
Cambria Smoothed Coal Co.
Lorenzo D. Weld
Schricker Heirs
Chas Ricketts
A.J. Fry
S. Hegarty
Lorenzo D. Weld
Schricker Heirs
Elizabeth Matthews