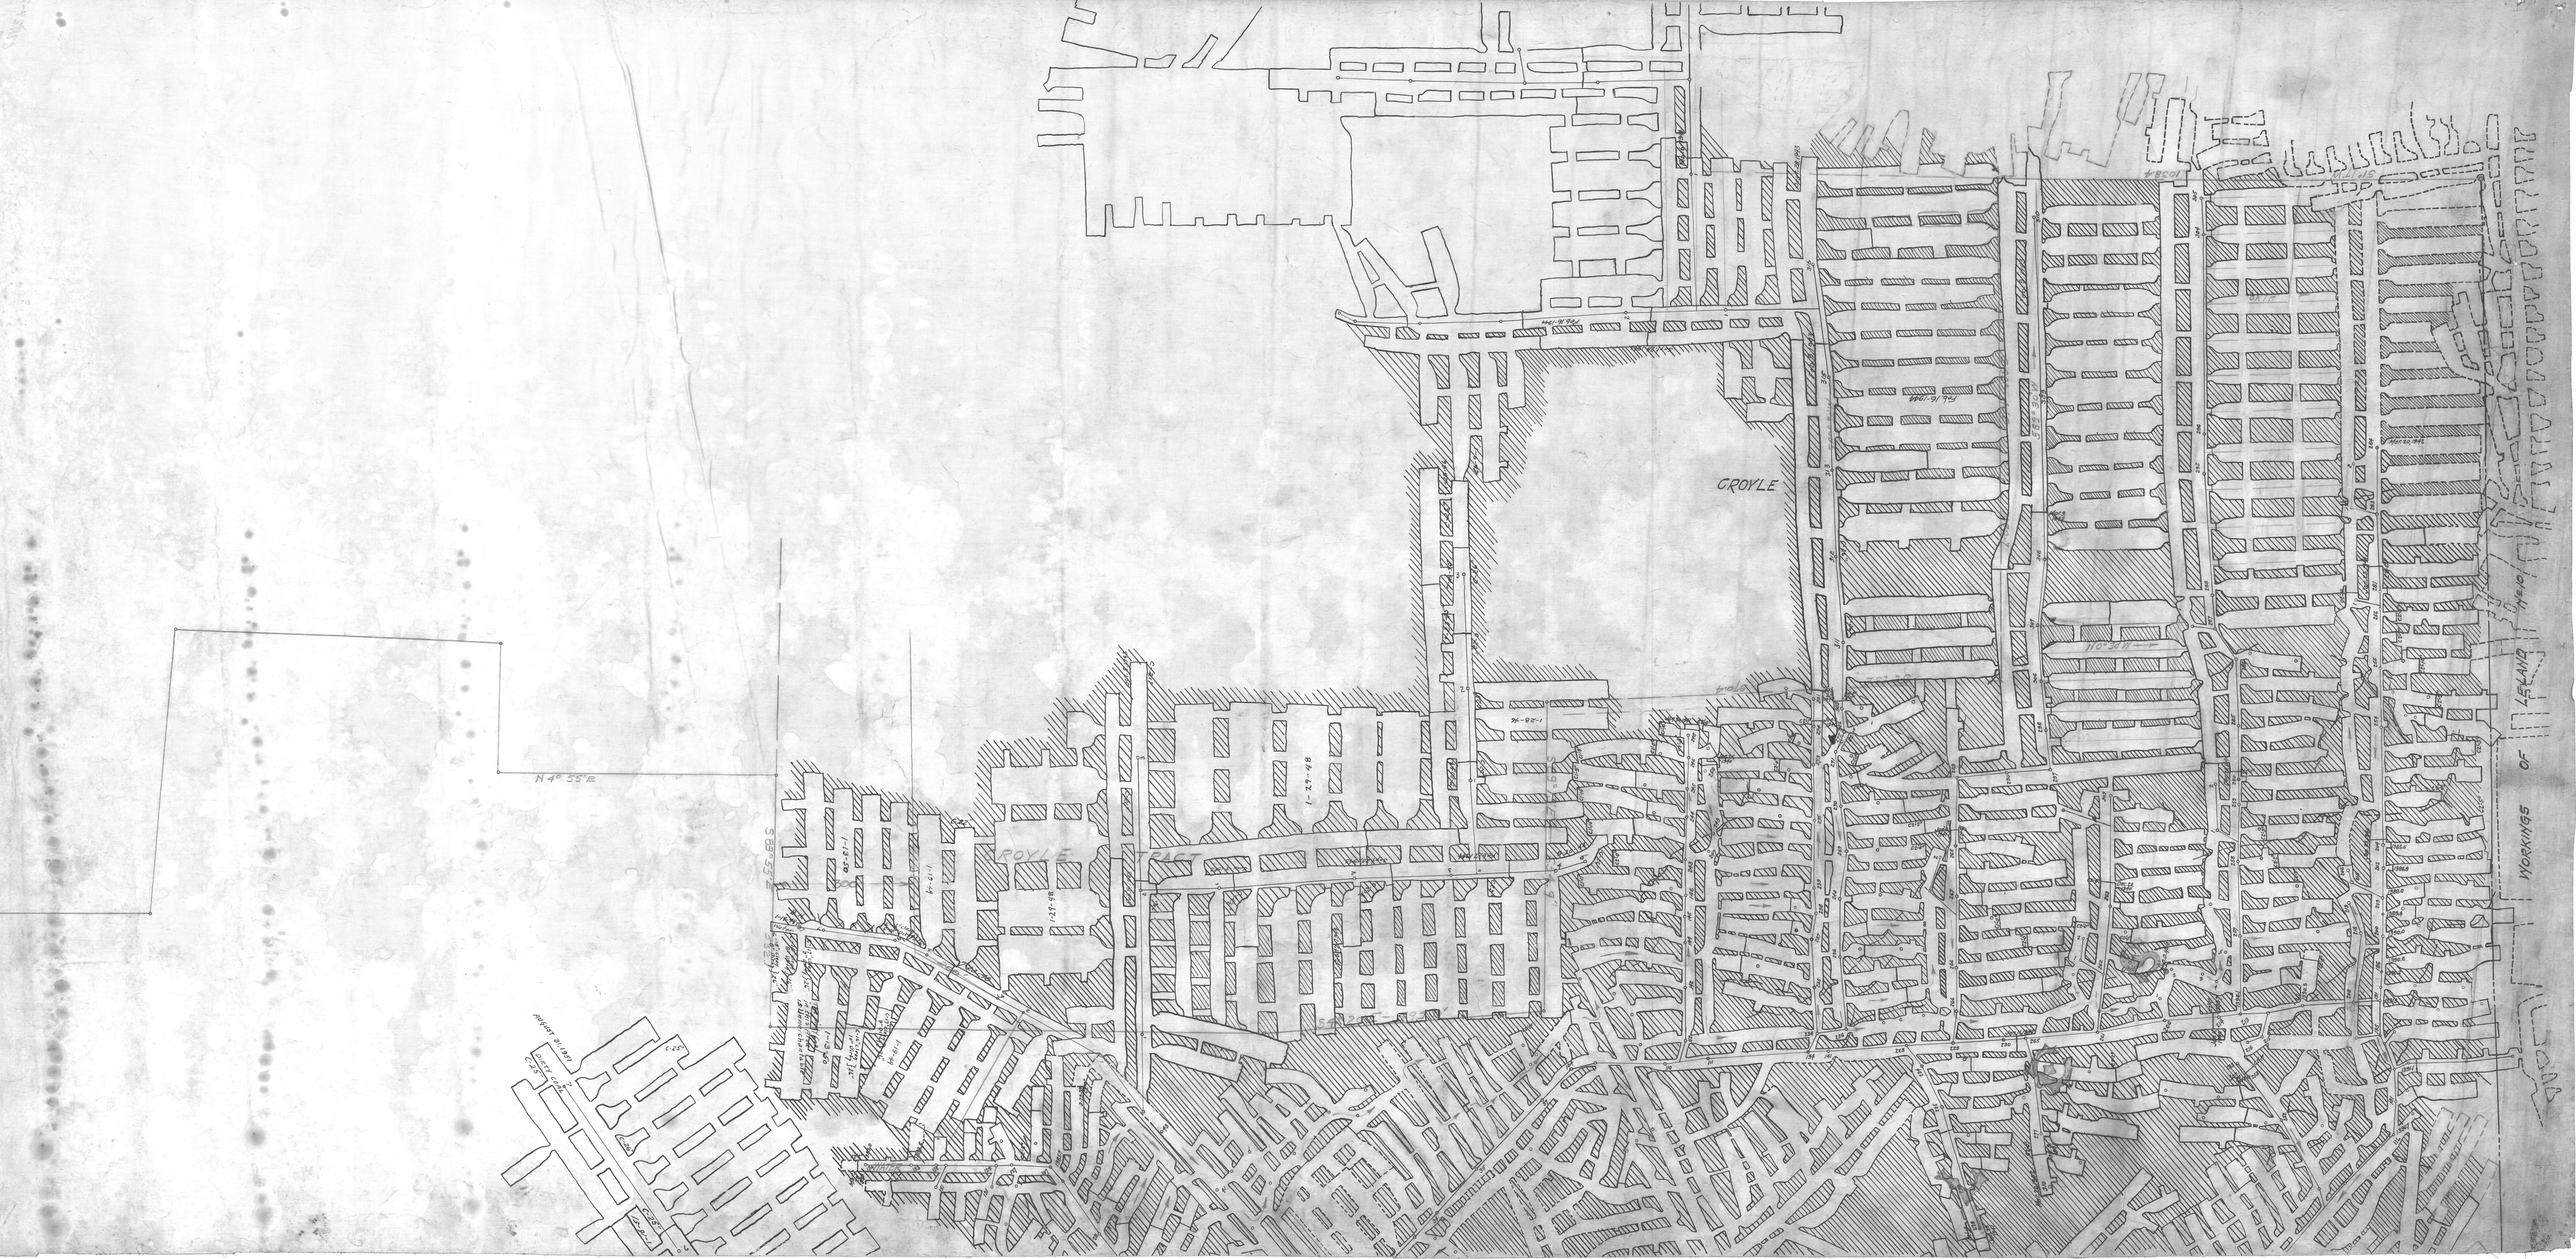

GROYLE
WORKINGS OF LEVANO
N 4° 55' E
S 85° 55' E
AUGUST 31 1951
Feb 16 1944