

POST & STONES

N0° 36' W


1153.91

POST
IN FENCE CAR

1722.70

50° 55' E

STONE

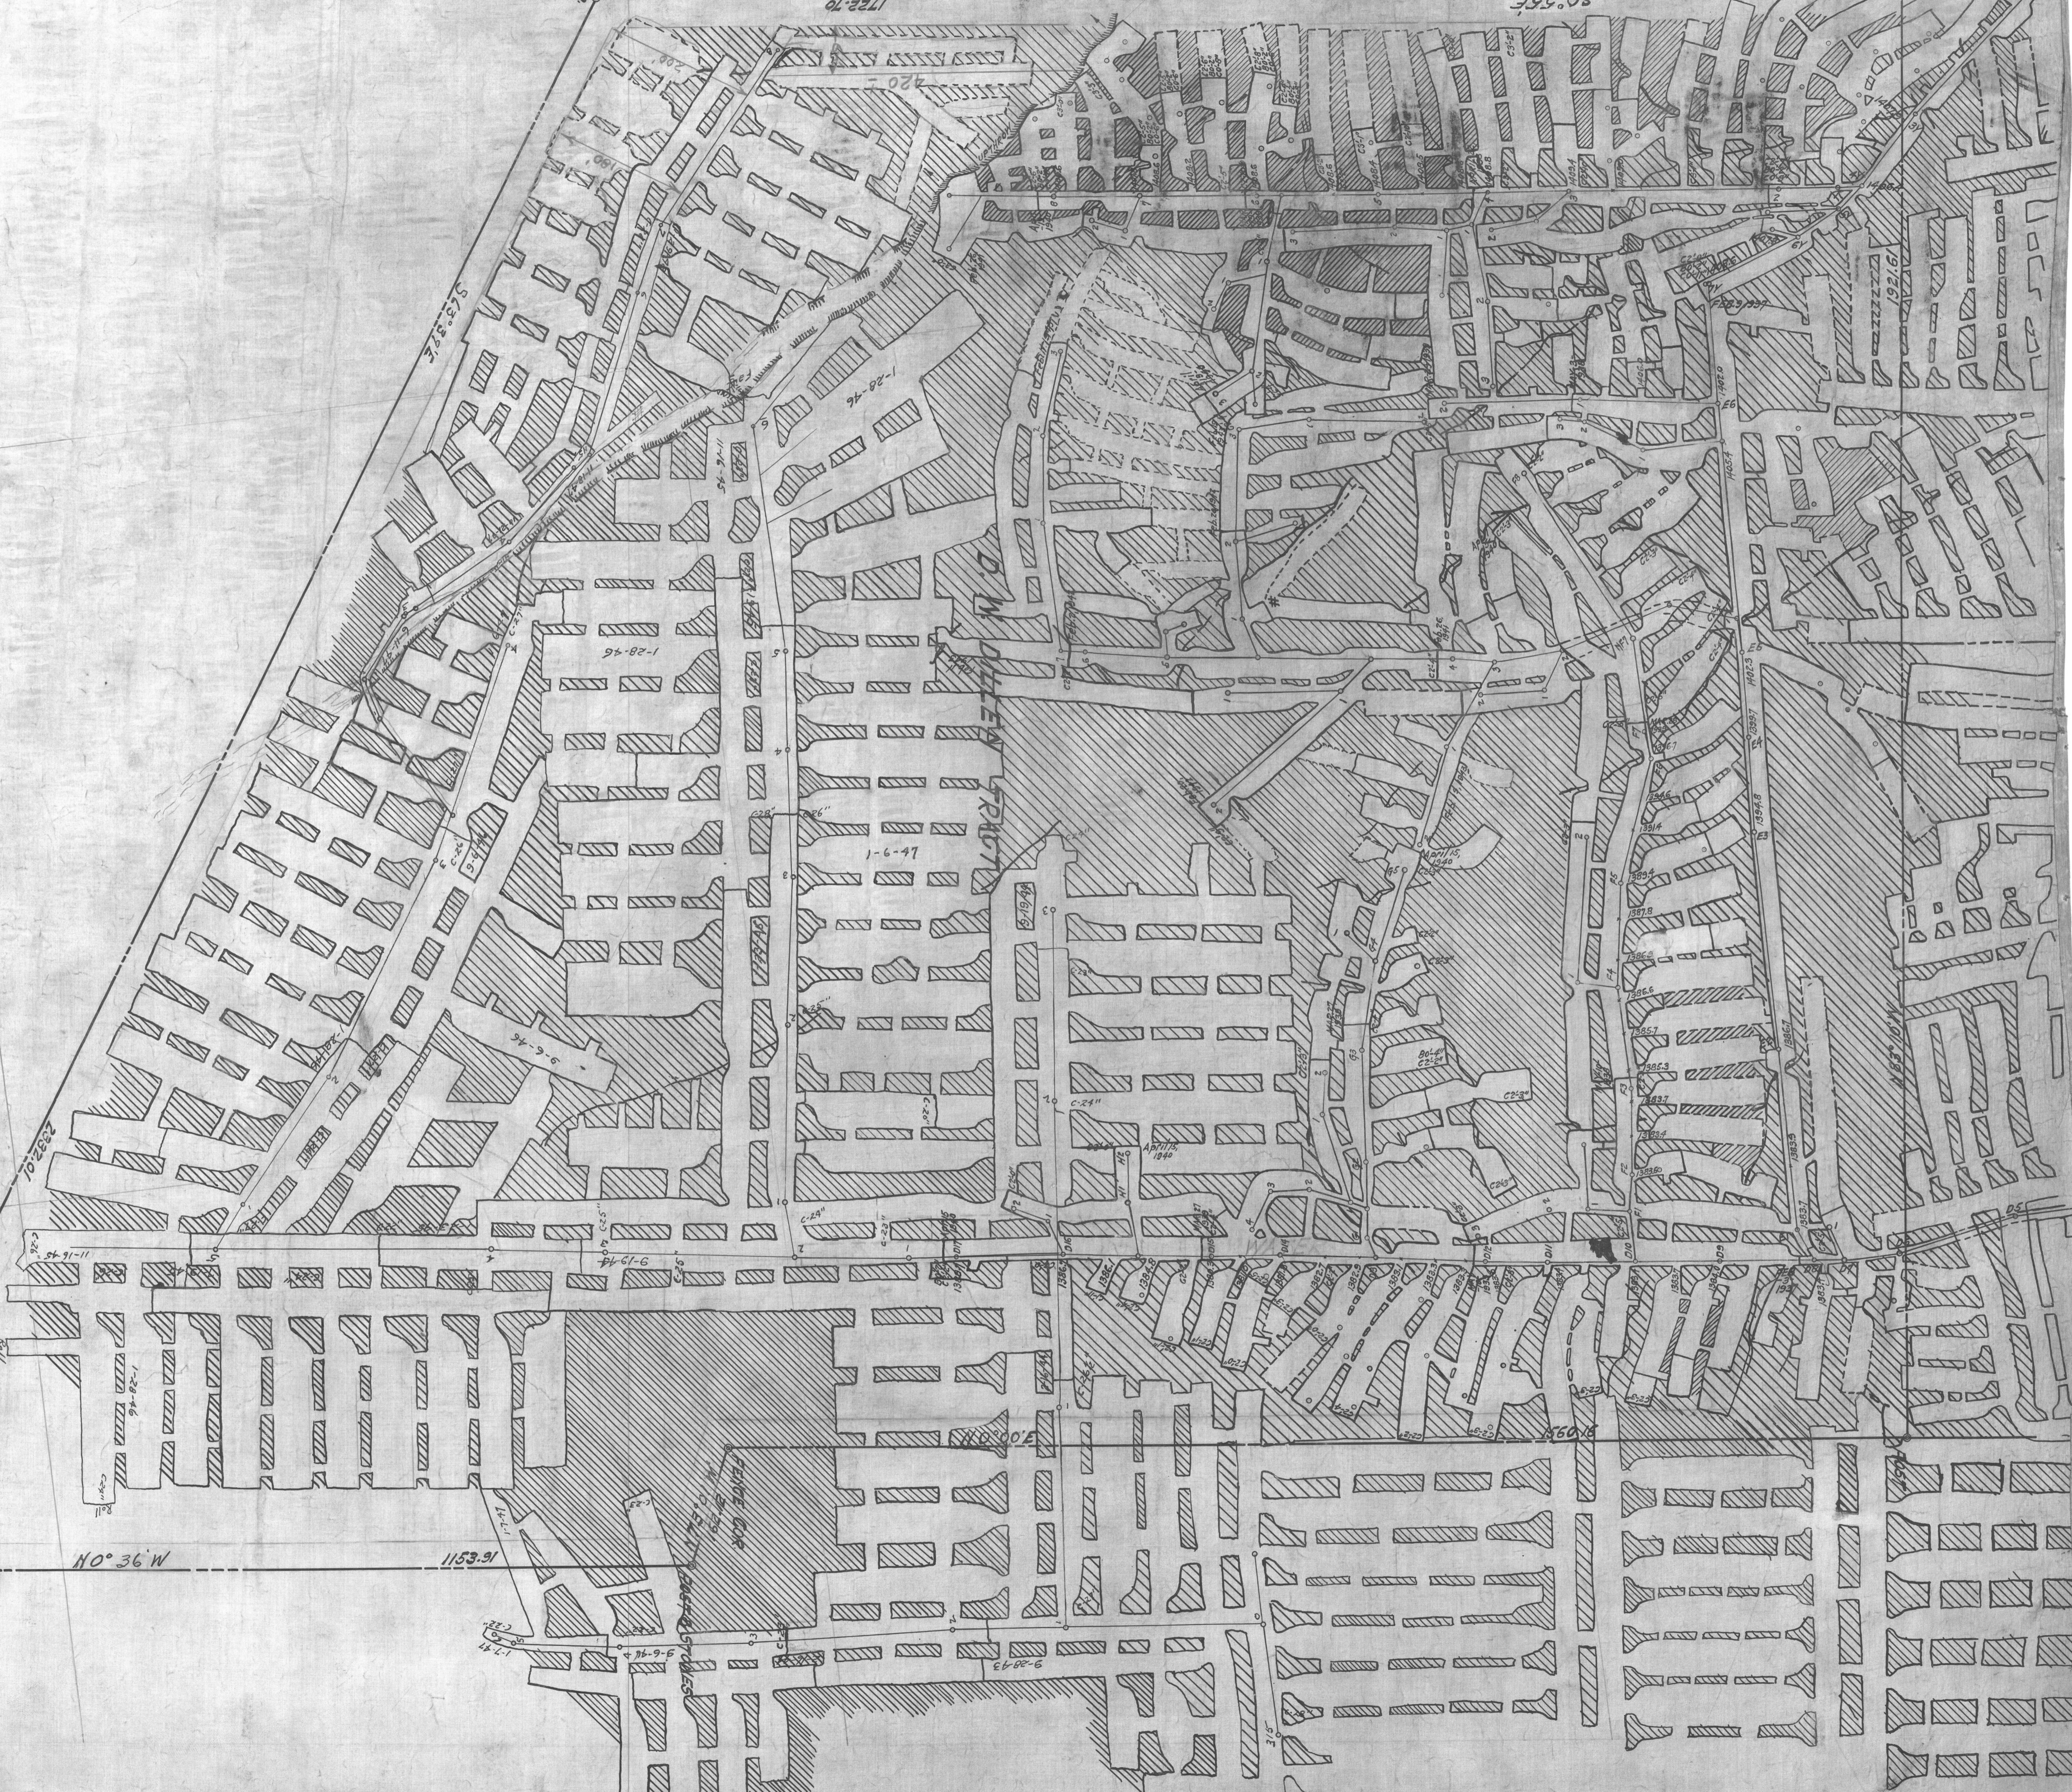

1-28-46

1-28-46

1-6-47

1-6-47

C-241

APR 1940

160.0

1-28-46

1-28-46

E 6-9-6

1-28-46

1-28-46

1-28-46

1-28-46

1-28-46

1-28-46

1-28-46

1-28-46