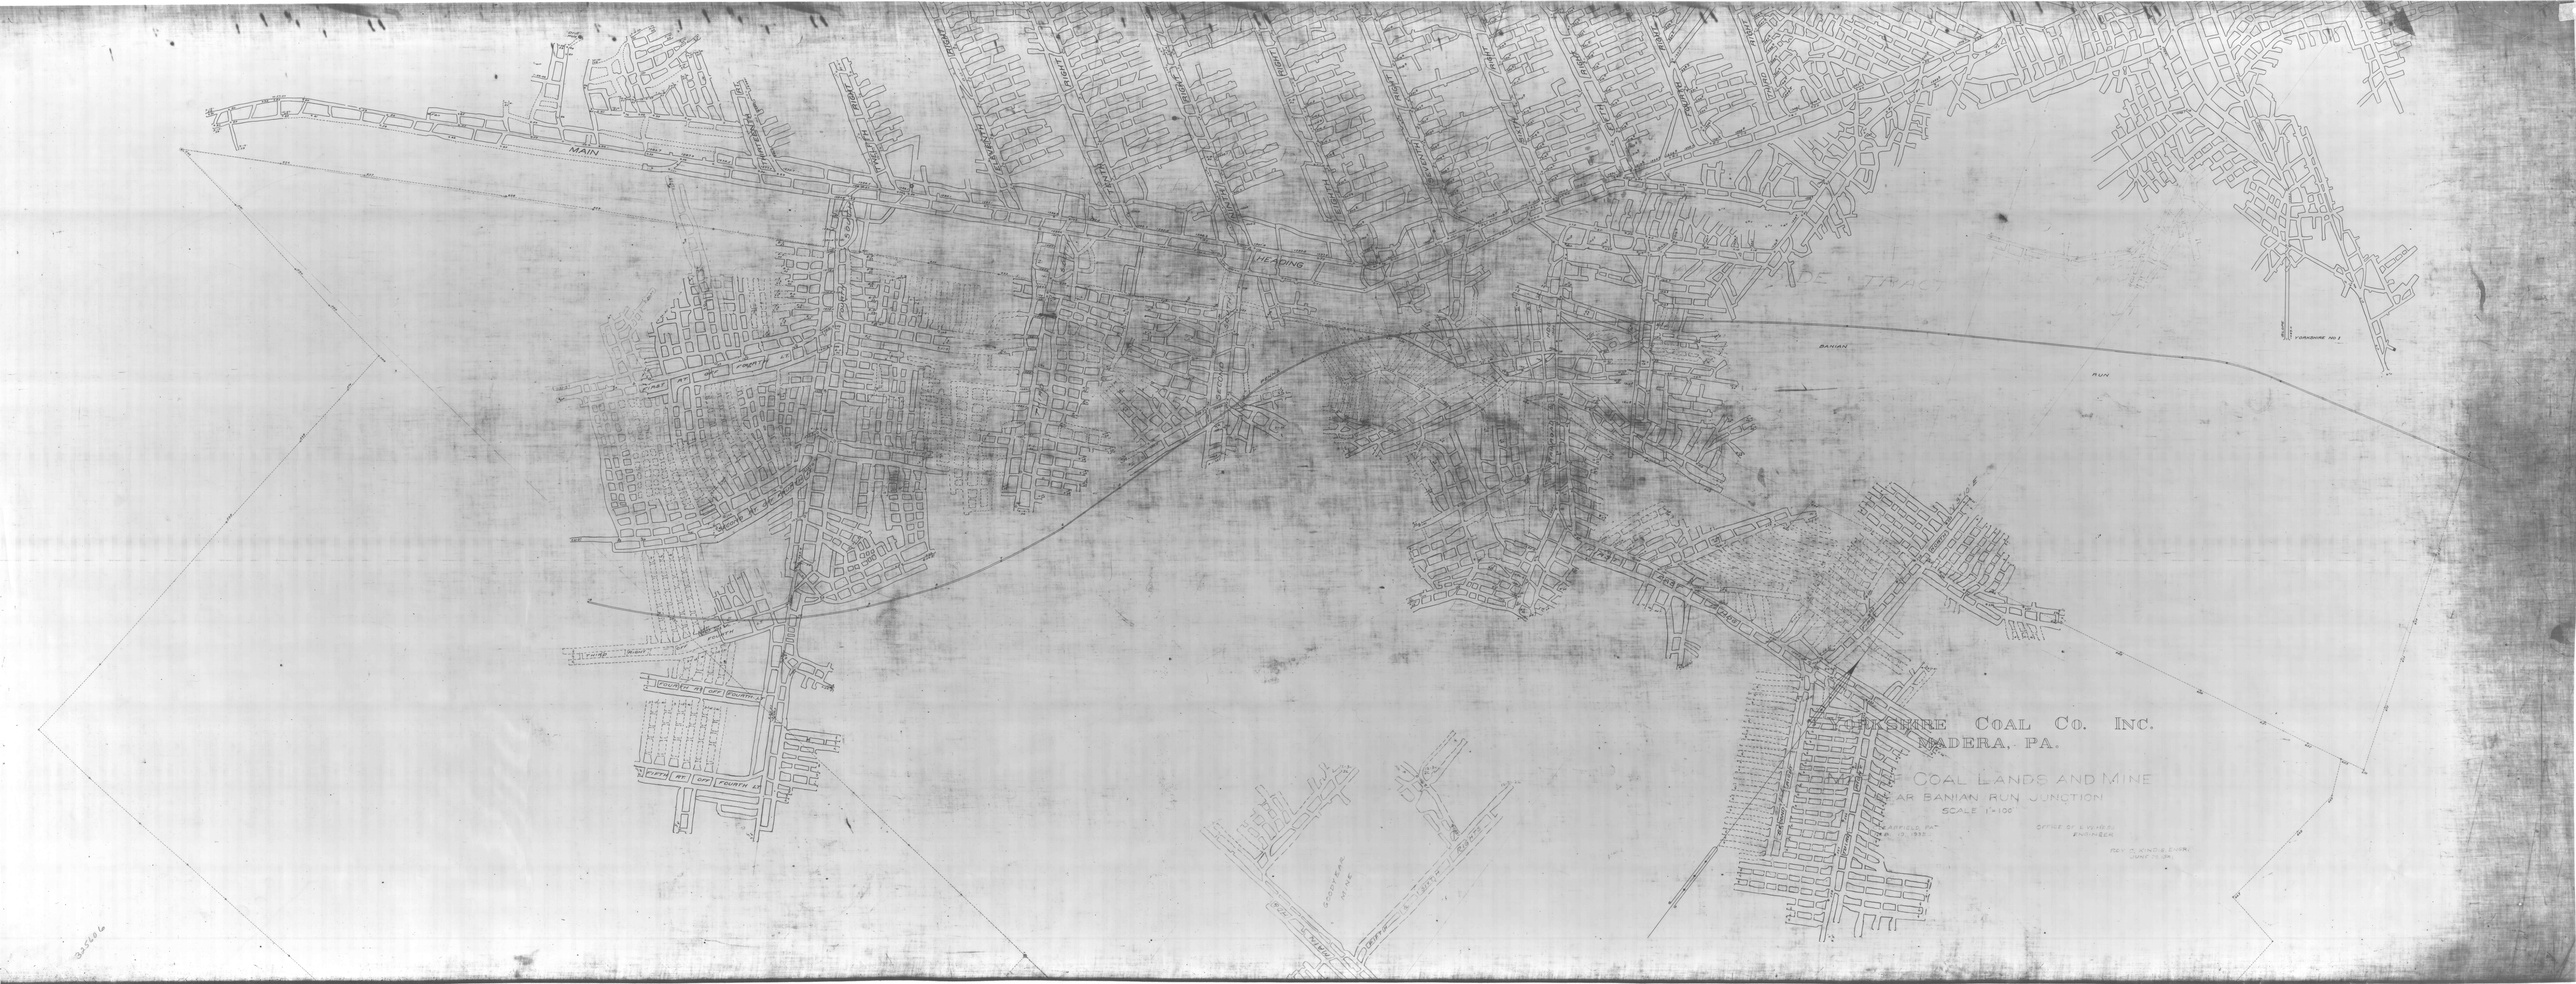
MAIN
HEADING
BANIAN
RUN
YORKSHIRE NO 1
YORKSHIRE COAL CO. INC.
MADERA, PA.
COAL LANDS AND MINE
NEAR BANIAN RUN JUNCTION
SCALE 1-100