

Check ls. for
farm-esp. sam.
take samples

STRIP

456800m N.

78°45'

689000m E.

41°15'

41°07'30"

DU BOIS 1:62,500

78°45'

41°15'

41°07'30"

78°45'

41°07'30"

DU BOIS 1:62,500

Finish sections
Photog.

Check this
69

Check
69

2" Coal blow
4 small bore
drill by 25 w/ah
(land fossils)

Consideration
Gas
Supply Co.
A. J. Babcock

4.9' 2' section
+ Jerris
+ Jerris


Walk
A. H. Trank

Bench

ELLIOTT PARK


Mapped, edited, and published by the Geological Survey
Control by USGS and USC&GS
Topography from aerial photographs by photogrammetric methods
Aerial photographs taken 1958. Field check 1959
Polyconic projection. 1927 North American datum
10,000-foot grid based on Pennsylvania coordinate system,
north zone
1000-meter Universal Transverse Mercator grid ticks,
zone 17, shown in blue
Fine red dashed lines indicate selected fence and field lines
visible on aerial photographs. This information is unchecked

APPROXIMATE MEAN
DECLINATION, 1959

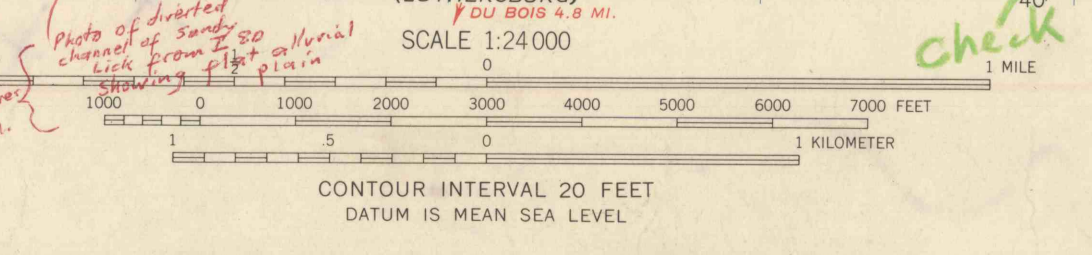

ROAD CLASSIFICATION

Heavy-duty	Light-duty
Medium-duty	Unimproved dirt
U.S. Route	State Route

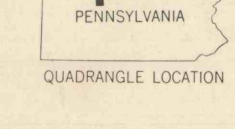

SABULA, PA.
NW/4 PENFIELD 15' QUADRANGLE
N4107.5-W7837.5/7.5