


MAP OF "B" SEAM MINE

OF

JAMES W. LAING

BECCARIA TWP. CLEARFIELD CO. PA. (Near Coalport.)

Scale :- 1" = 100' Oct. 27, 1920 J. S. Sillyman & Co. Engrs.

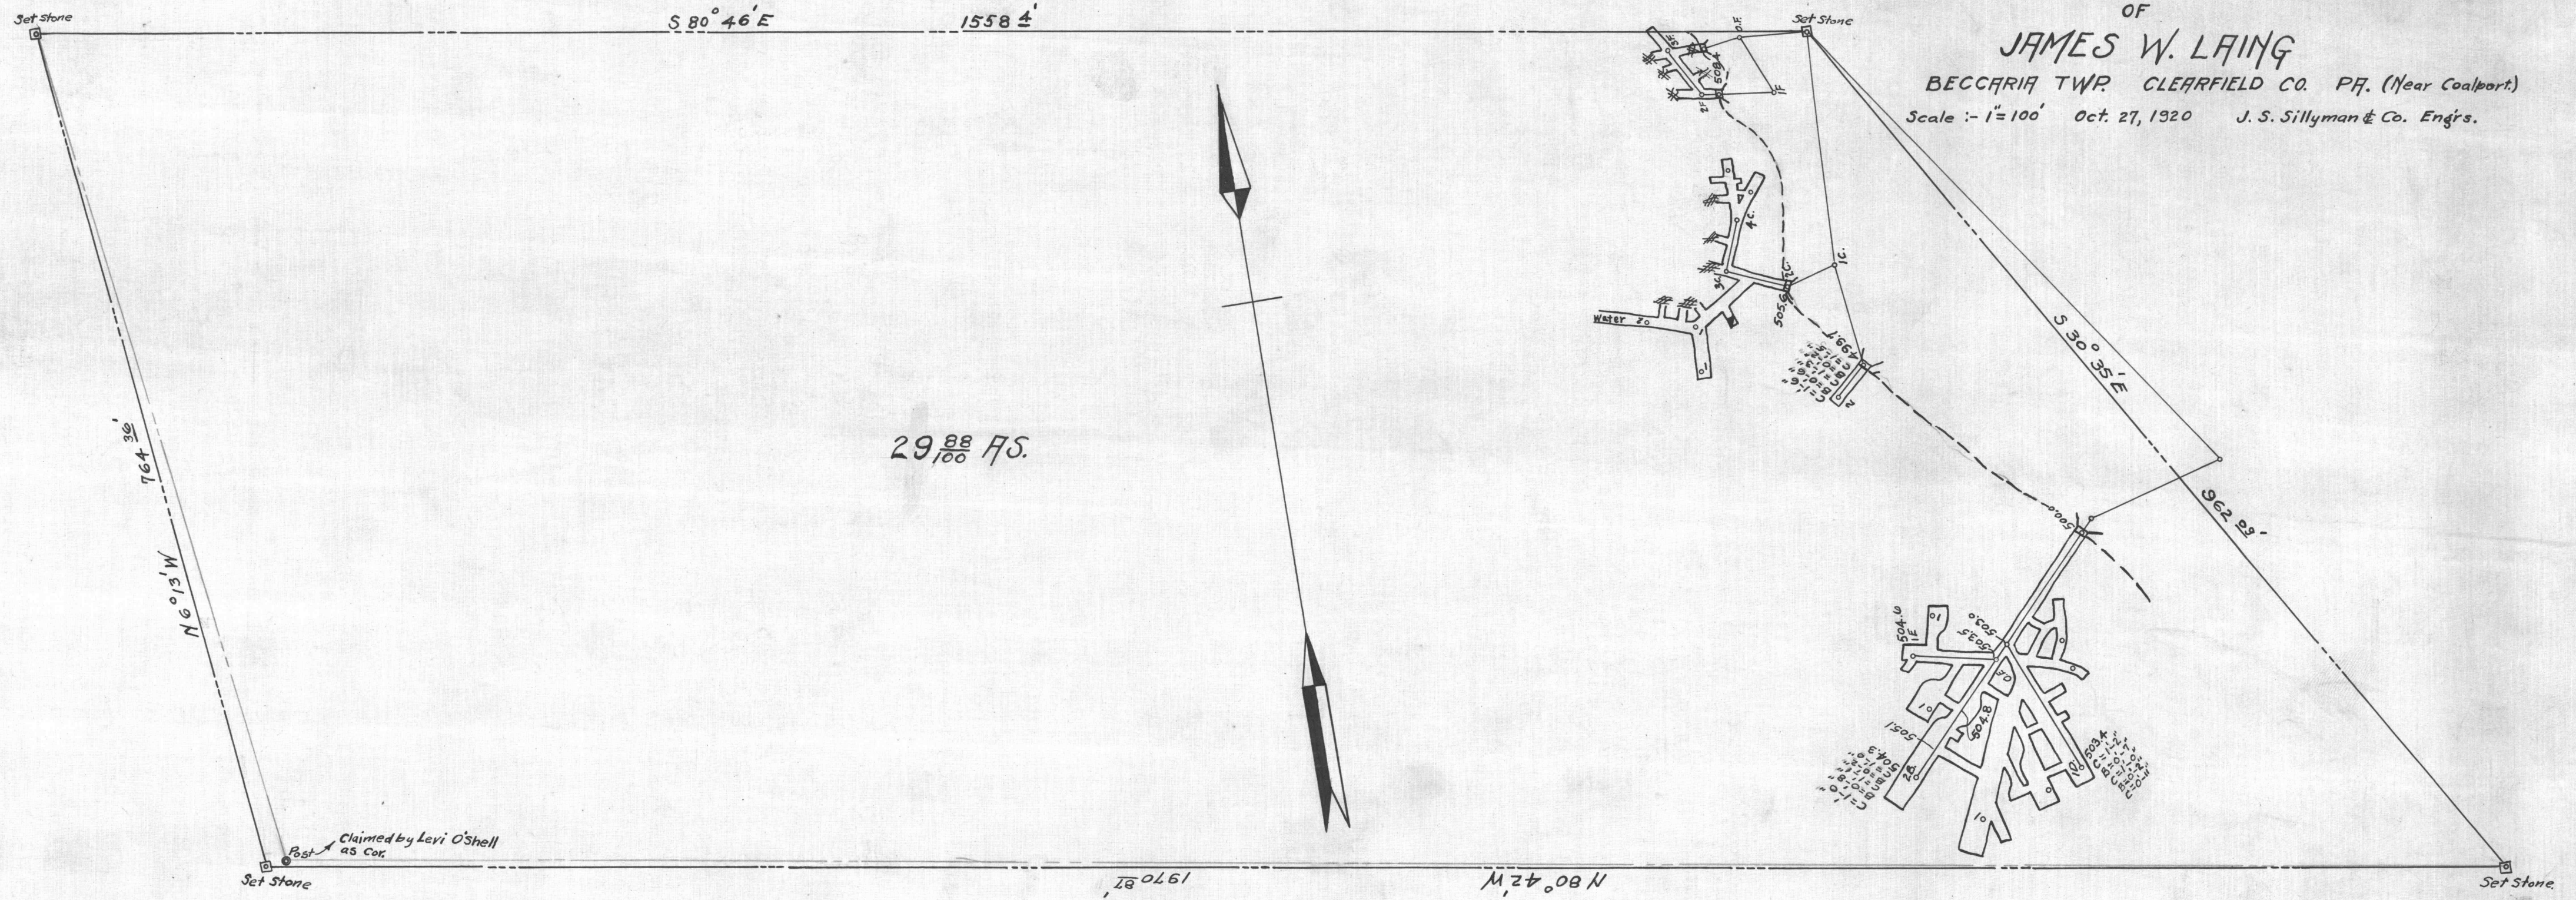

~~57058~~ M-3