


LELAND GOAL MINING CO.
 MAP OF COAL LANDS
 AND
 MINE WORKINGS
 NEAR
 BEGGARIA, CLEARFIELD COUNTY, PA.
 SCALE: -1"=400'

W.A. SILLIMAN,
 MINING ENGR.
 ALTOONA, PA.

MINE WORKINGS REVISED TO [REDACTED]

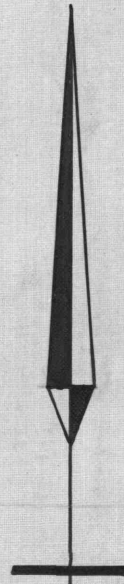

JOHN MCGOY
 259 A5.

FRANK MCGOY
 317.768

MURRAY - SUR. & COAL
 158.76'E

A. IRVIN

P. FLYNN TRACT
 104.8226

LEMUEL SEMPLE - SURFACE
 SEMPLE HRS. - COAL

MRS. G. G. GOPENHAVER
 TRACT
 AARON EMLER - SURFACE.
 COAL LEASED TO
 WILLIAM SMITH.

SAMUEL SEMPLE.

SHOFF HRS. 47
 66.08 A5.
 WILLIAM SMITH - COAL

ANDREW SHOFF TRACT.
 TOTAL AREA 115.64 A5.

LELAND GOAL MINING CO.
 - 43.28 A5.
 COAL

D. K. RAMEY

MINED OUT.

DAVIS
 70 A5.

MINED OUT.

MINED OUT.

A. G. SMITH TRACT.
 JOHN KOLLAR (SUR)
 47.92 A5.

JOHN LITZ HRS.

BERWIND WHITE COAL MINING CO.

P. O'SHELL
 SUR

BERWIND WHITE
 COAL MINING CO.

