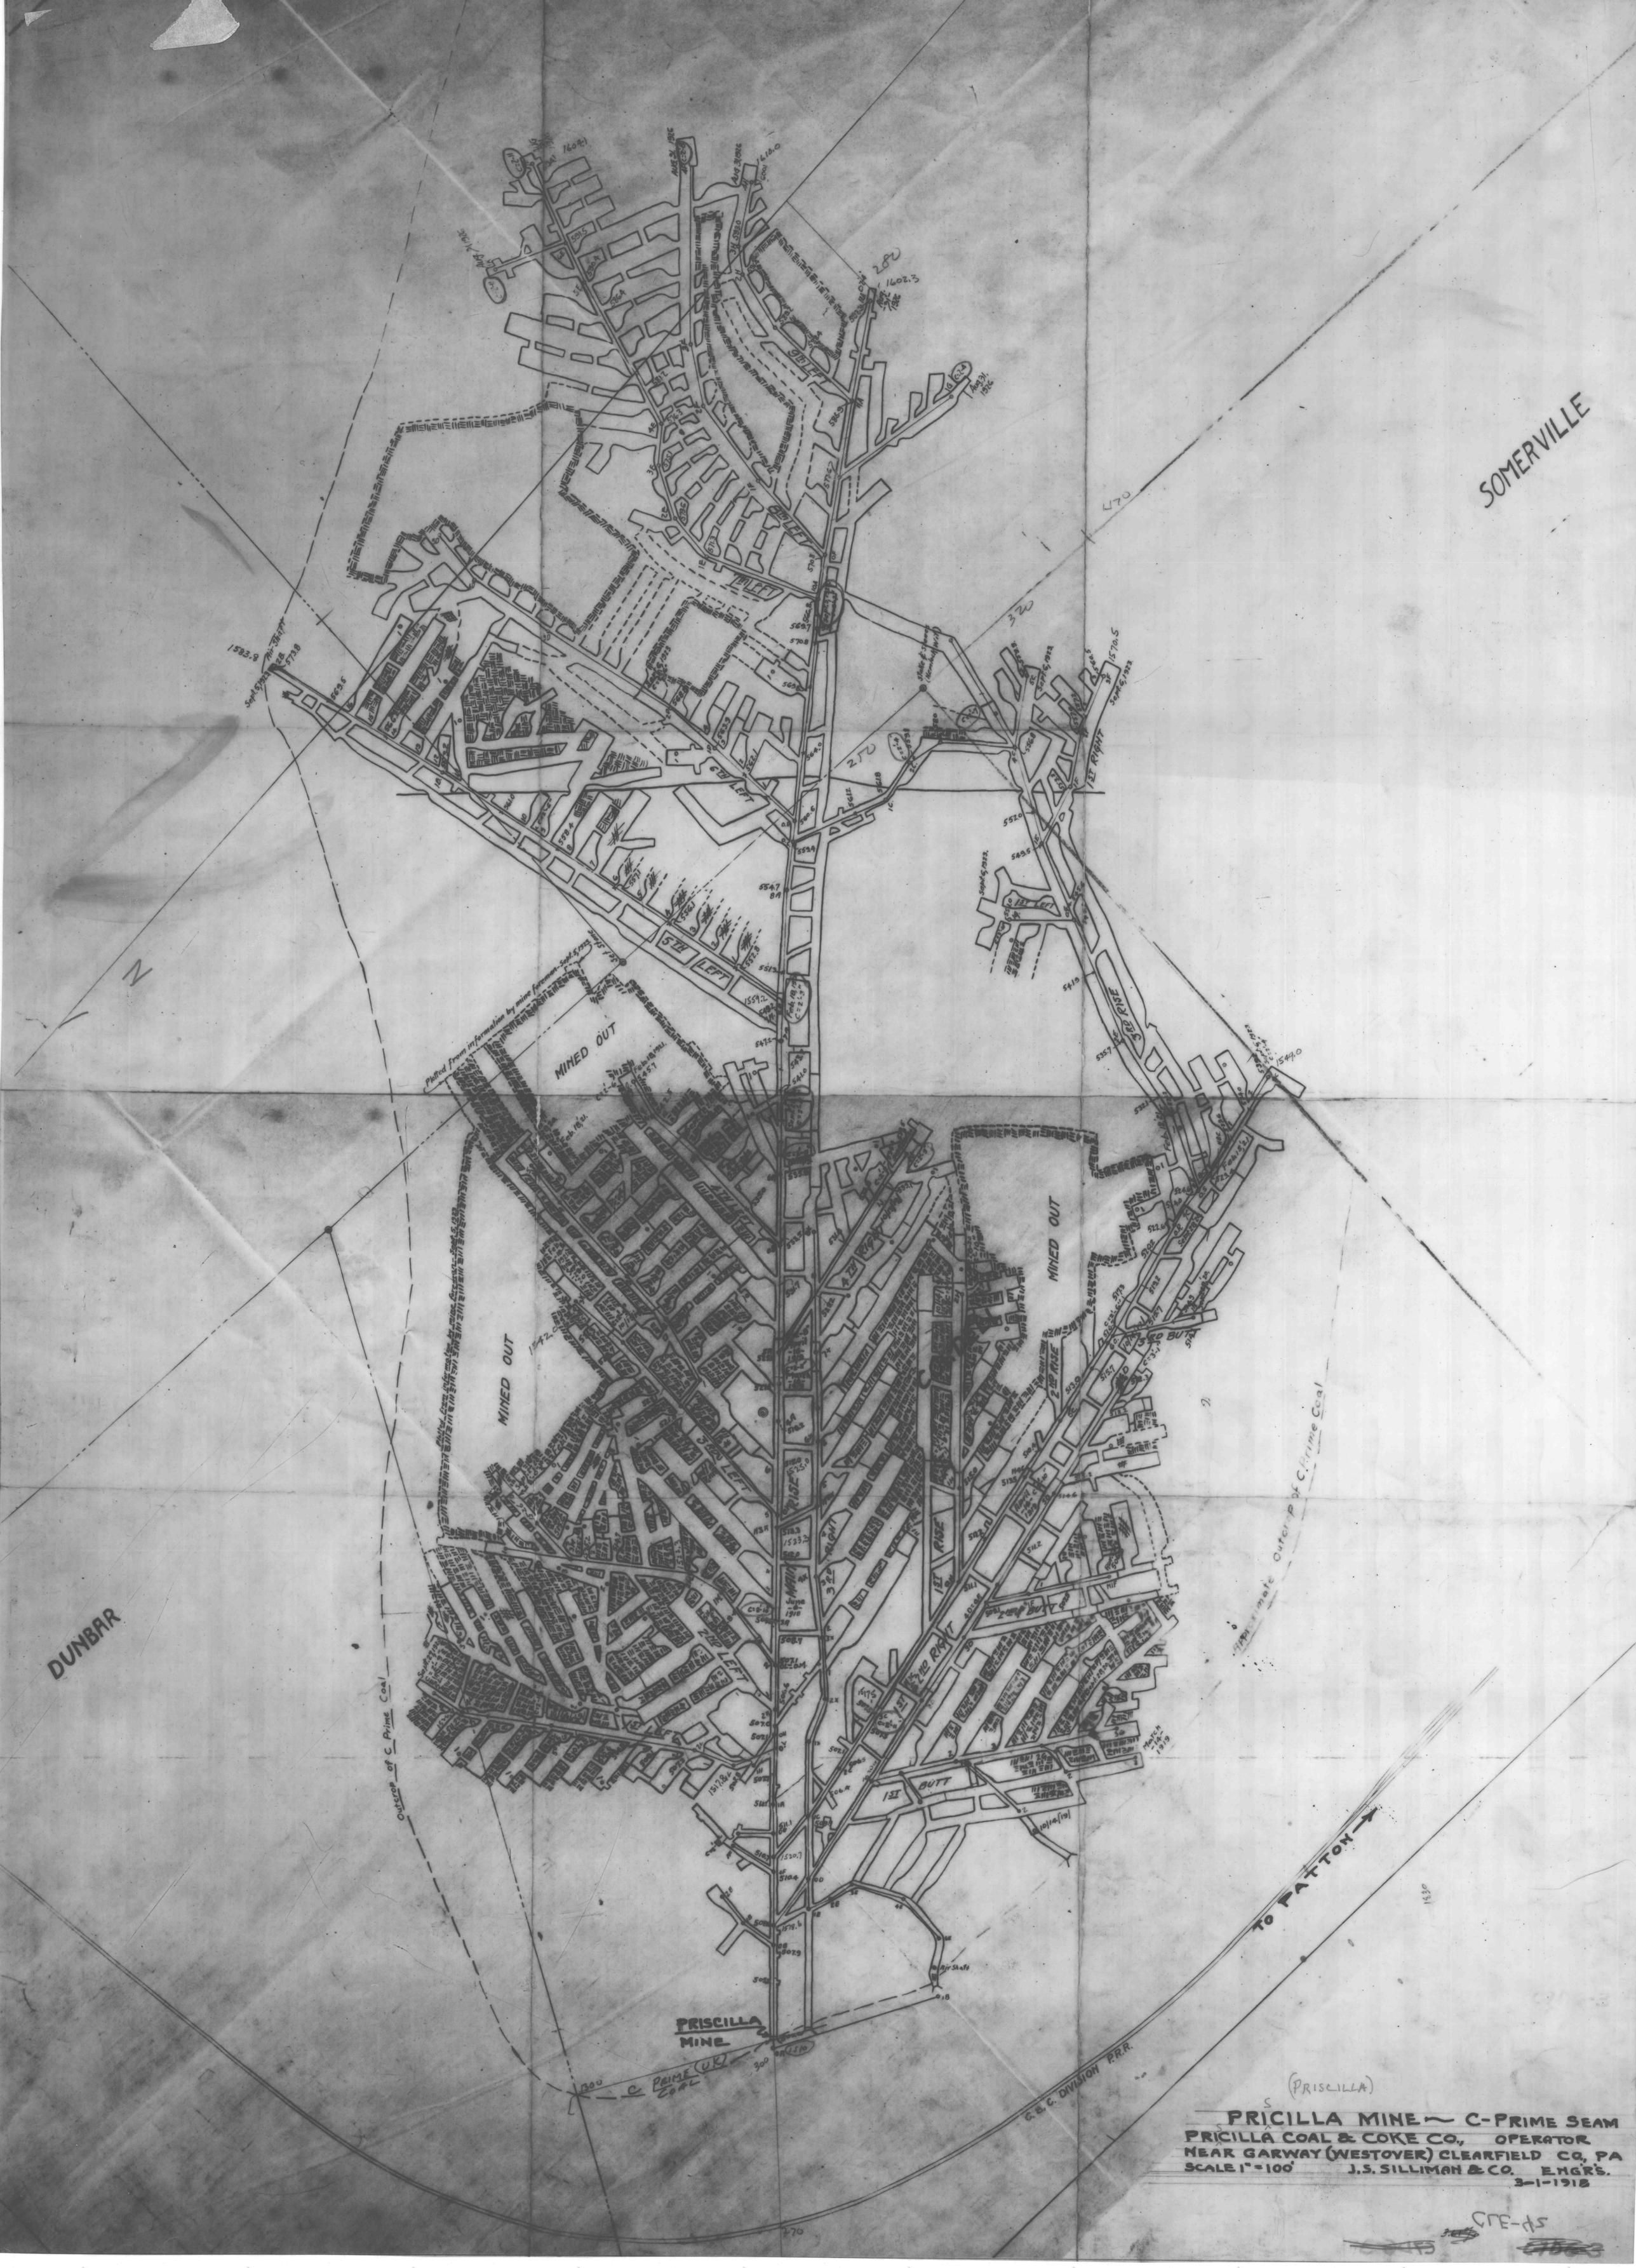
SOMERVILLE
DUNBAR
MINED OUT
MINED OUT
MINED OUT
PRISCILLA MINE
TO PATTON
C. & C. DIVISION P.R.R.
Approximate Outcrop of C Prime Coal
Outcrop of C Prime Coal
C PRIME COAL (UK)
Air Shaft
1ST BUTT
2ND BUTT
3RD BUTT
1ST RISE
2ND RISE
3RD RISE
4TH RISE
5TH RISE
6TH LEFT
5TH LEFT
4TH LEFT
3RD LEFT
2ND LEFT
1ST LEFT
Plotted from information by mine foreman-Sept.5,1923
Sept.5,1923
Aug.31,1926
Aug.31,1926
Aug.24,1926
Aug.24,1926
Sept.5,1923
Sept.5,1923
Sept.5,1923
Sept.5,1923
Feb.19,'21
Feb.19,'21
June 8 1916
March 28 1919
10/14/19
1583.9
1602.3
1618.0
1604.1
1570.5
1549.0
1542.0
1530
1578.6
1559.2
1520.7
1512.8
1523.2
1523.0
1539.1
1539.2
