


PA-533

Map showing
 PROPERTY LEASED
 BY
IRVONA COAL COMPANY
 NEAR
Coalport, Clearfield County, Pa.
 SCALE: 1" = 400'
 JOS. S. SILLYMAN,
 Engineer.
 1900.

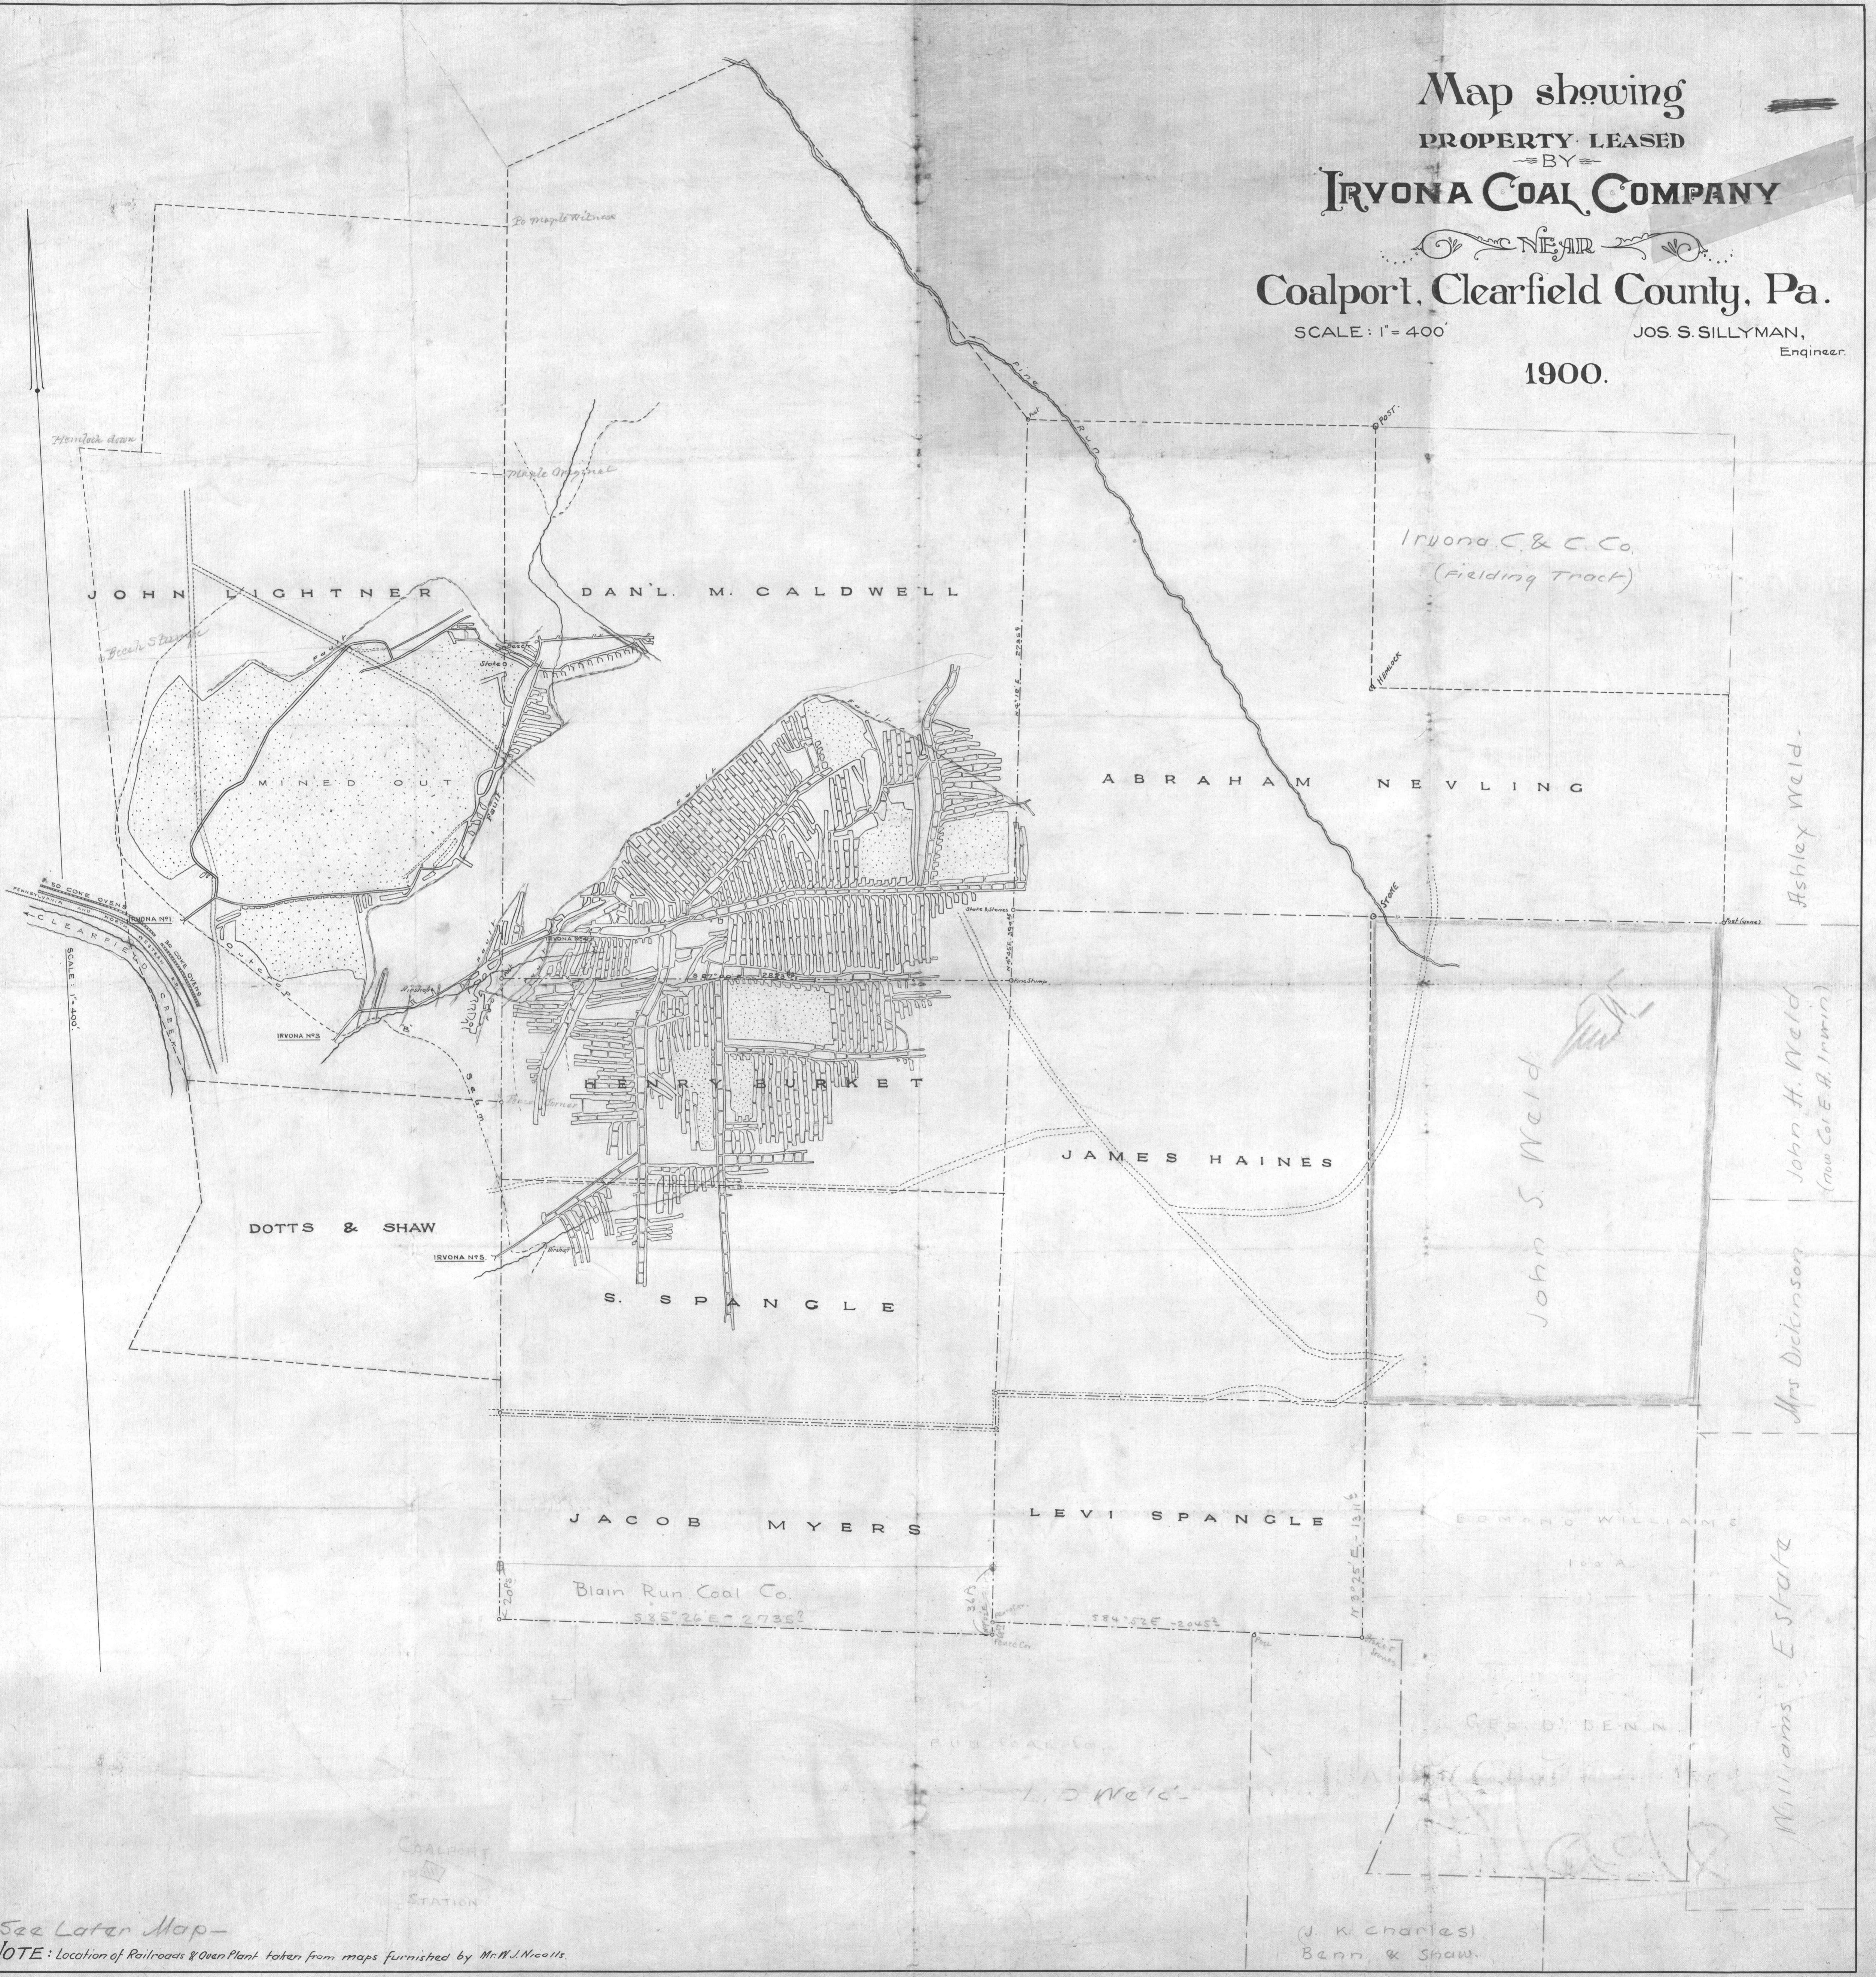

See Later Map -
 NOTE: Location of Railroads & Oven Plant taken from maps furnished by Mr. M. J. Nicolls.

(J. K. Charles)
 Benn & Shaw.