


Edge of plot facing

JOHN S. WELD

Stone

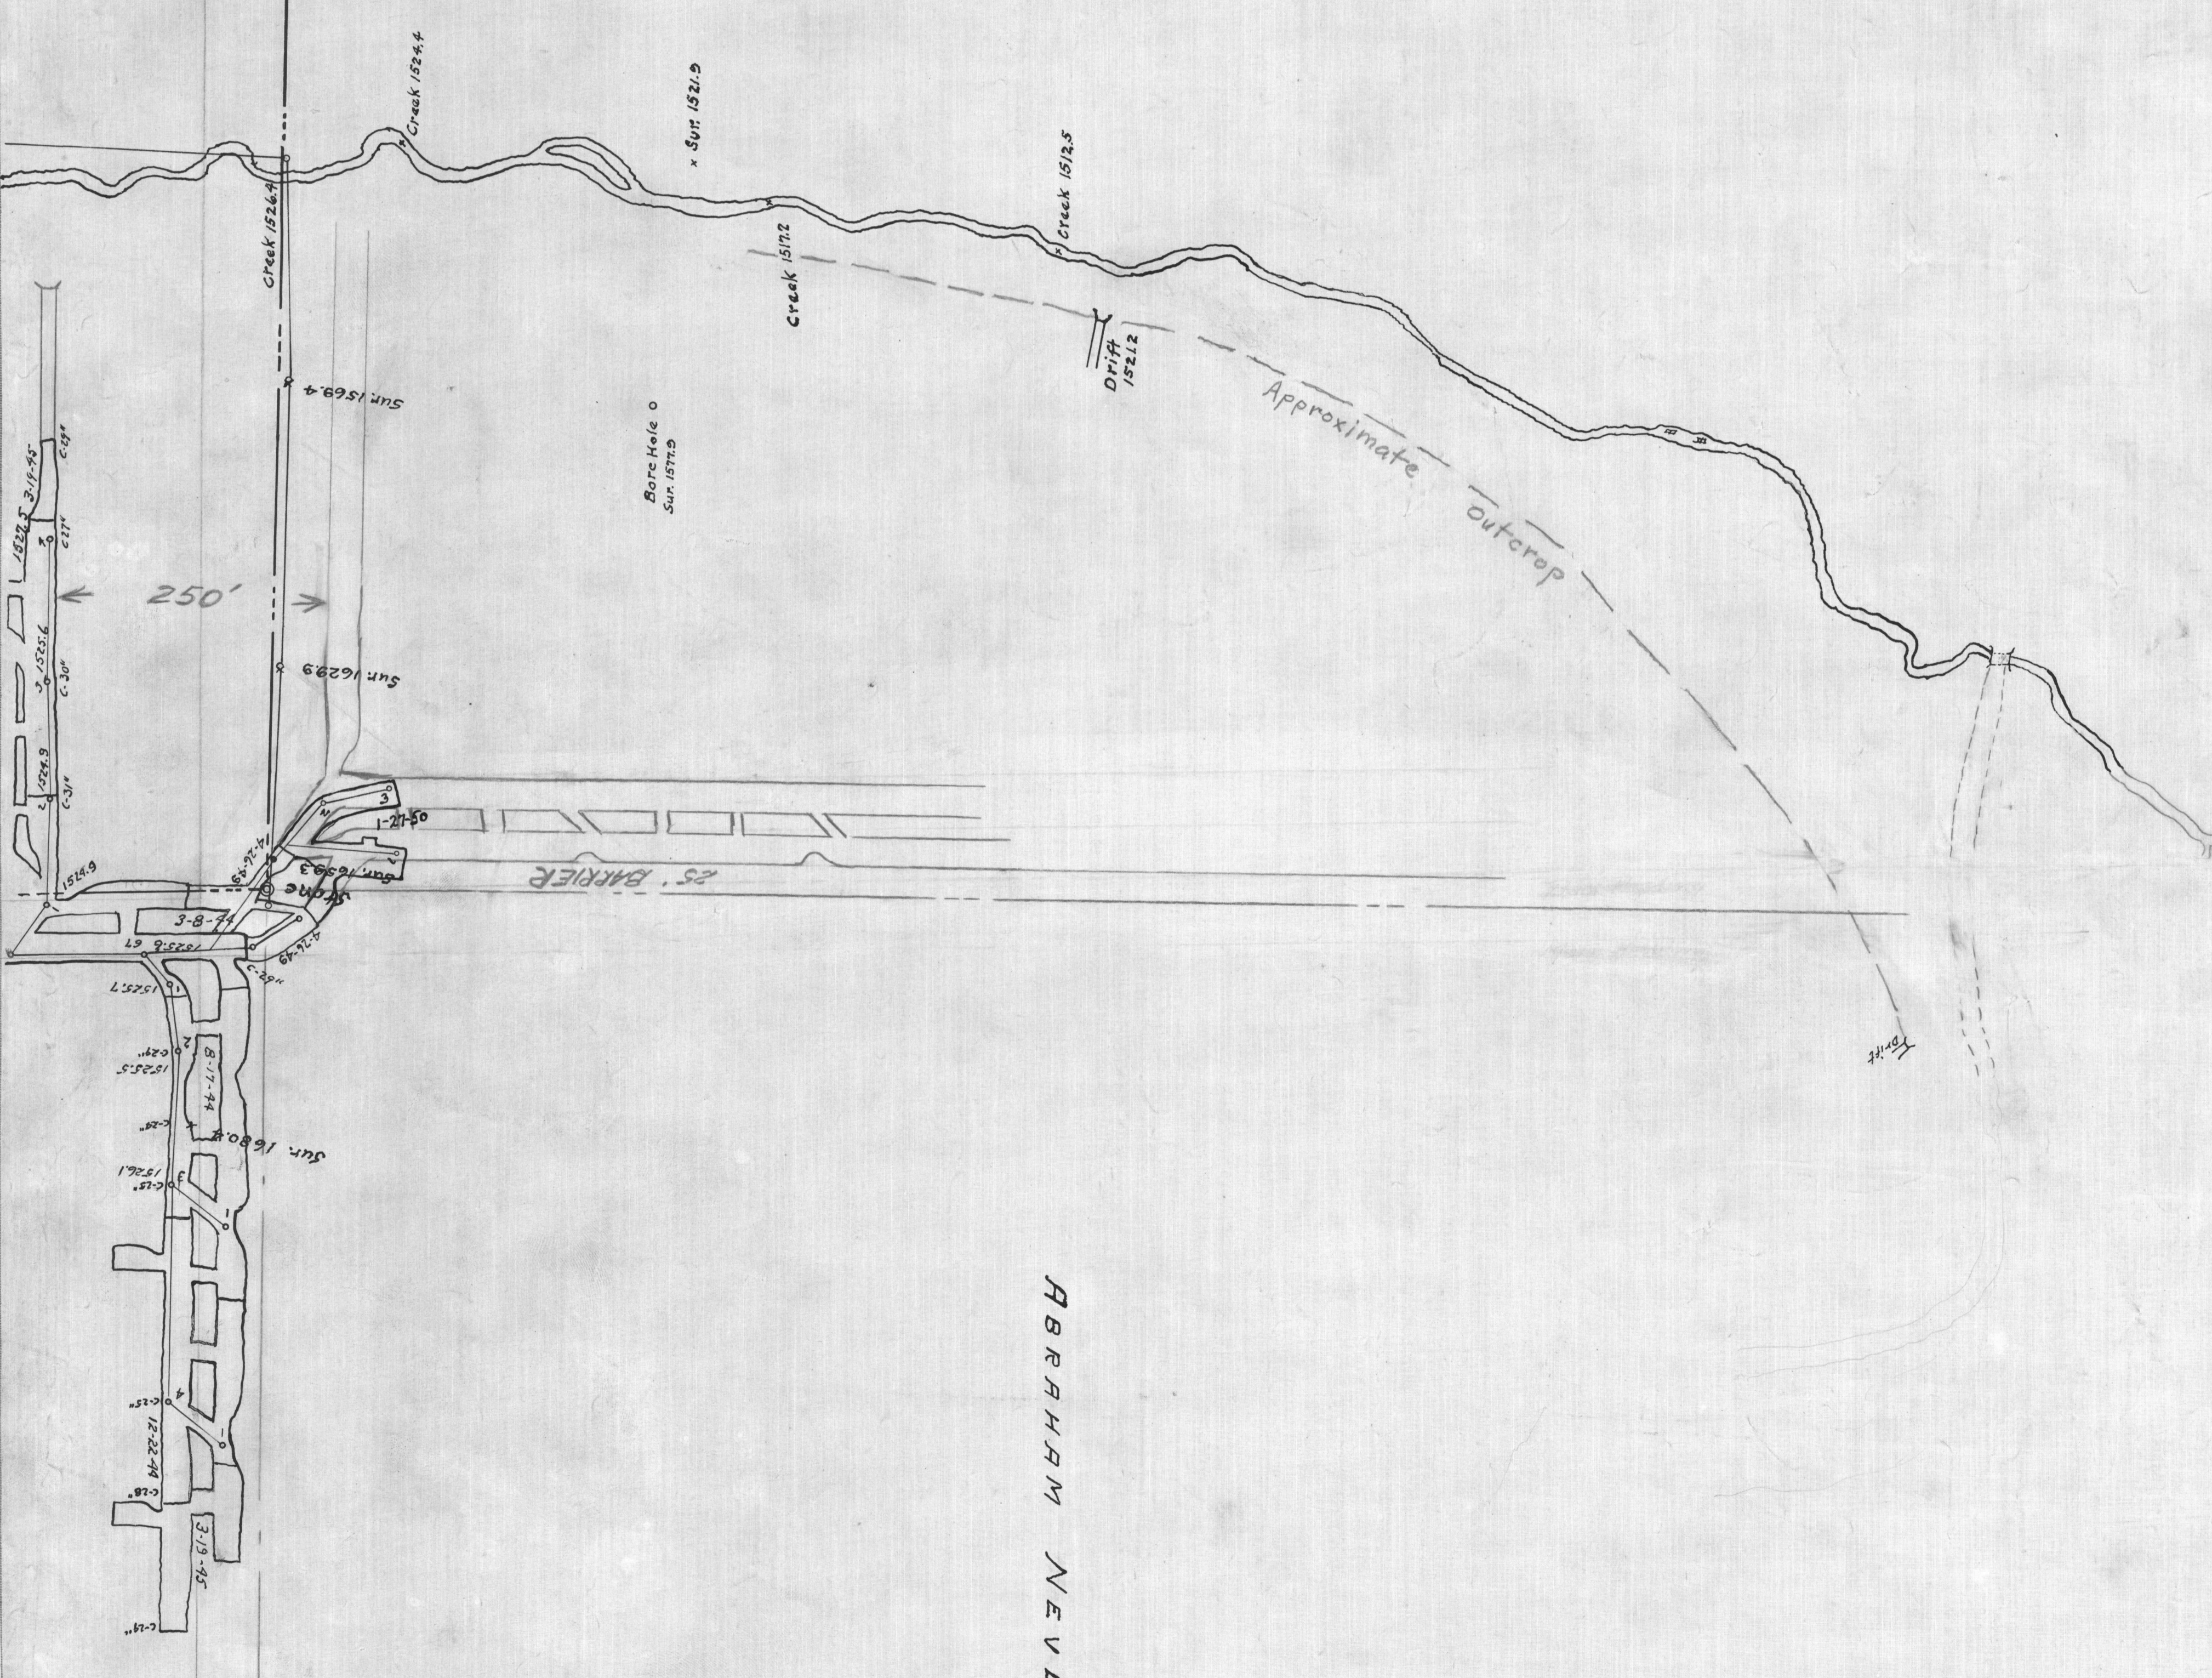

ABRAHAM NEVLING

Edge of plot facing