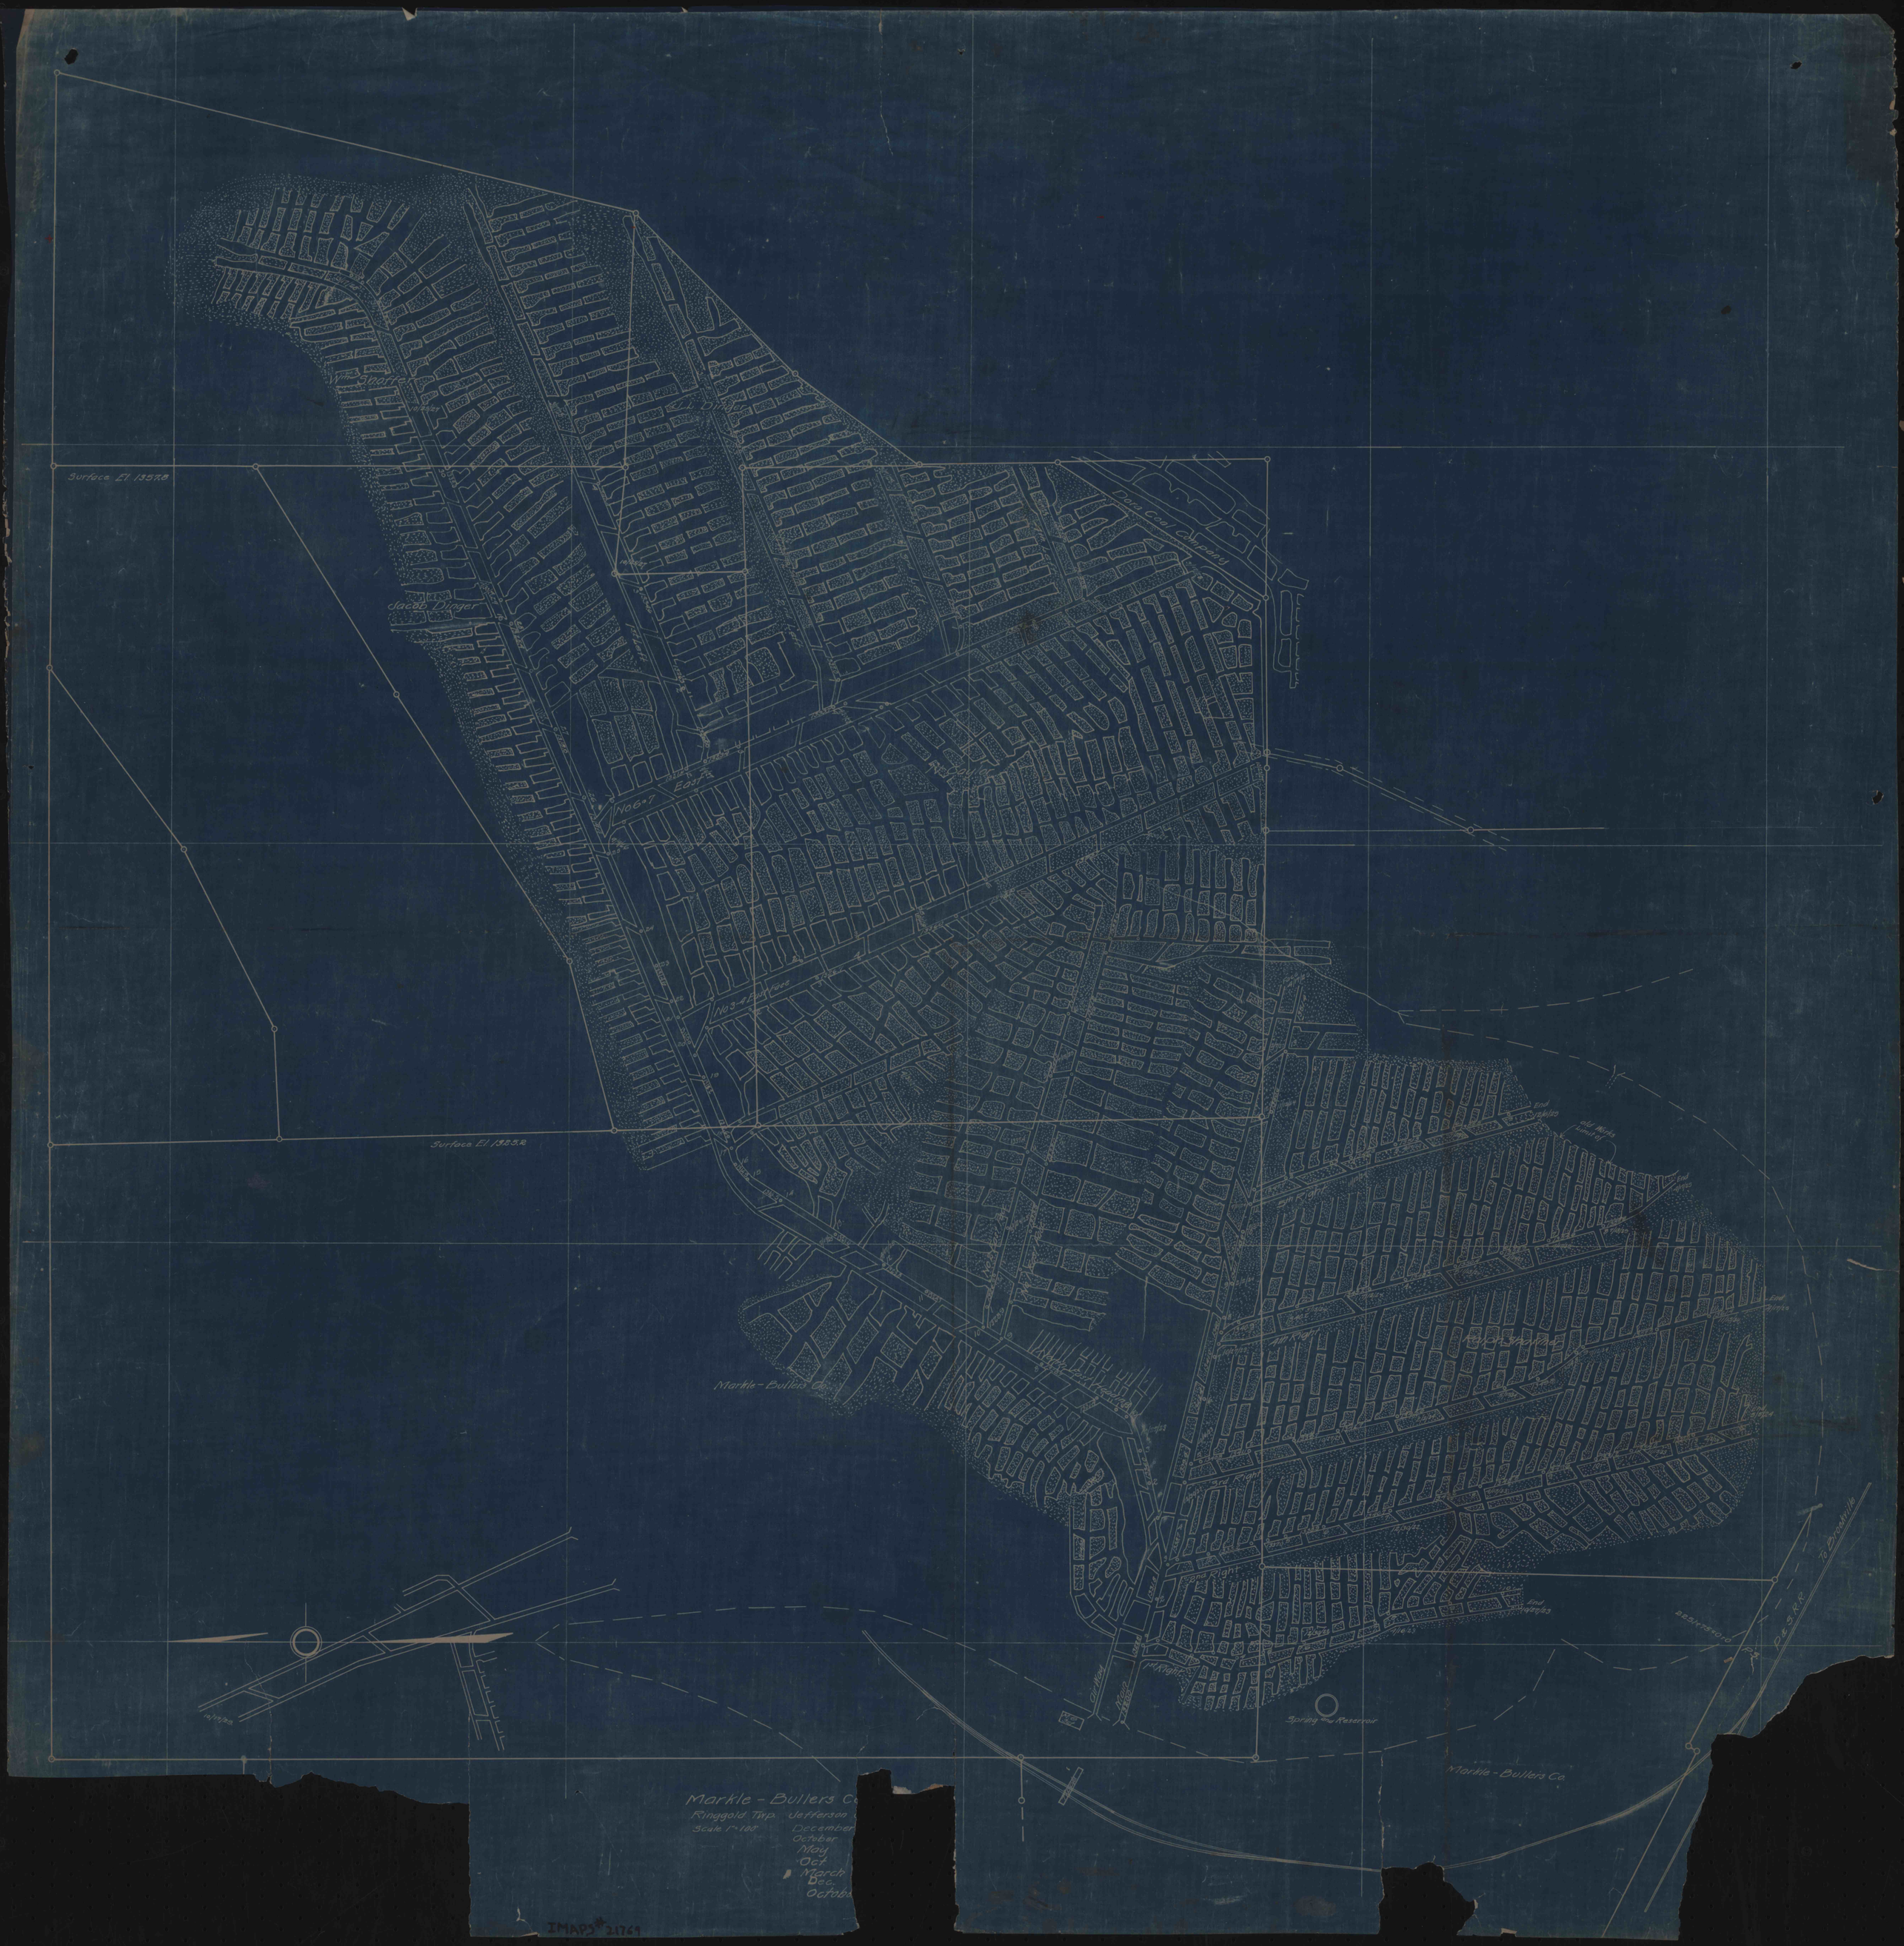

Surface El. 1357.8
Jacob Dinger
Dora Coal Company
No 6 & 7 East
No 3-4 East Face
Surface El. 1325.2
Markle-Bullers Co.
Spring and Reservoir
Markle-Bullers Co.
Markle - Bullers Co
Ringgold Twp. Jefferson
Scale 1"=100'
December
October
May
Oct.
March
Dec.
IMAPS# 21769