

7000.0 West

7000.0 North


6000.0 West

6000.0 North

5000.0 West

4000.0 West

5000.0 North

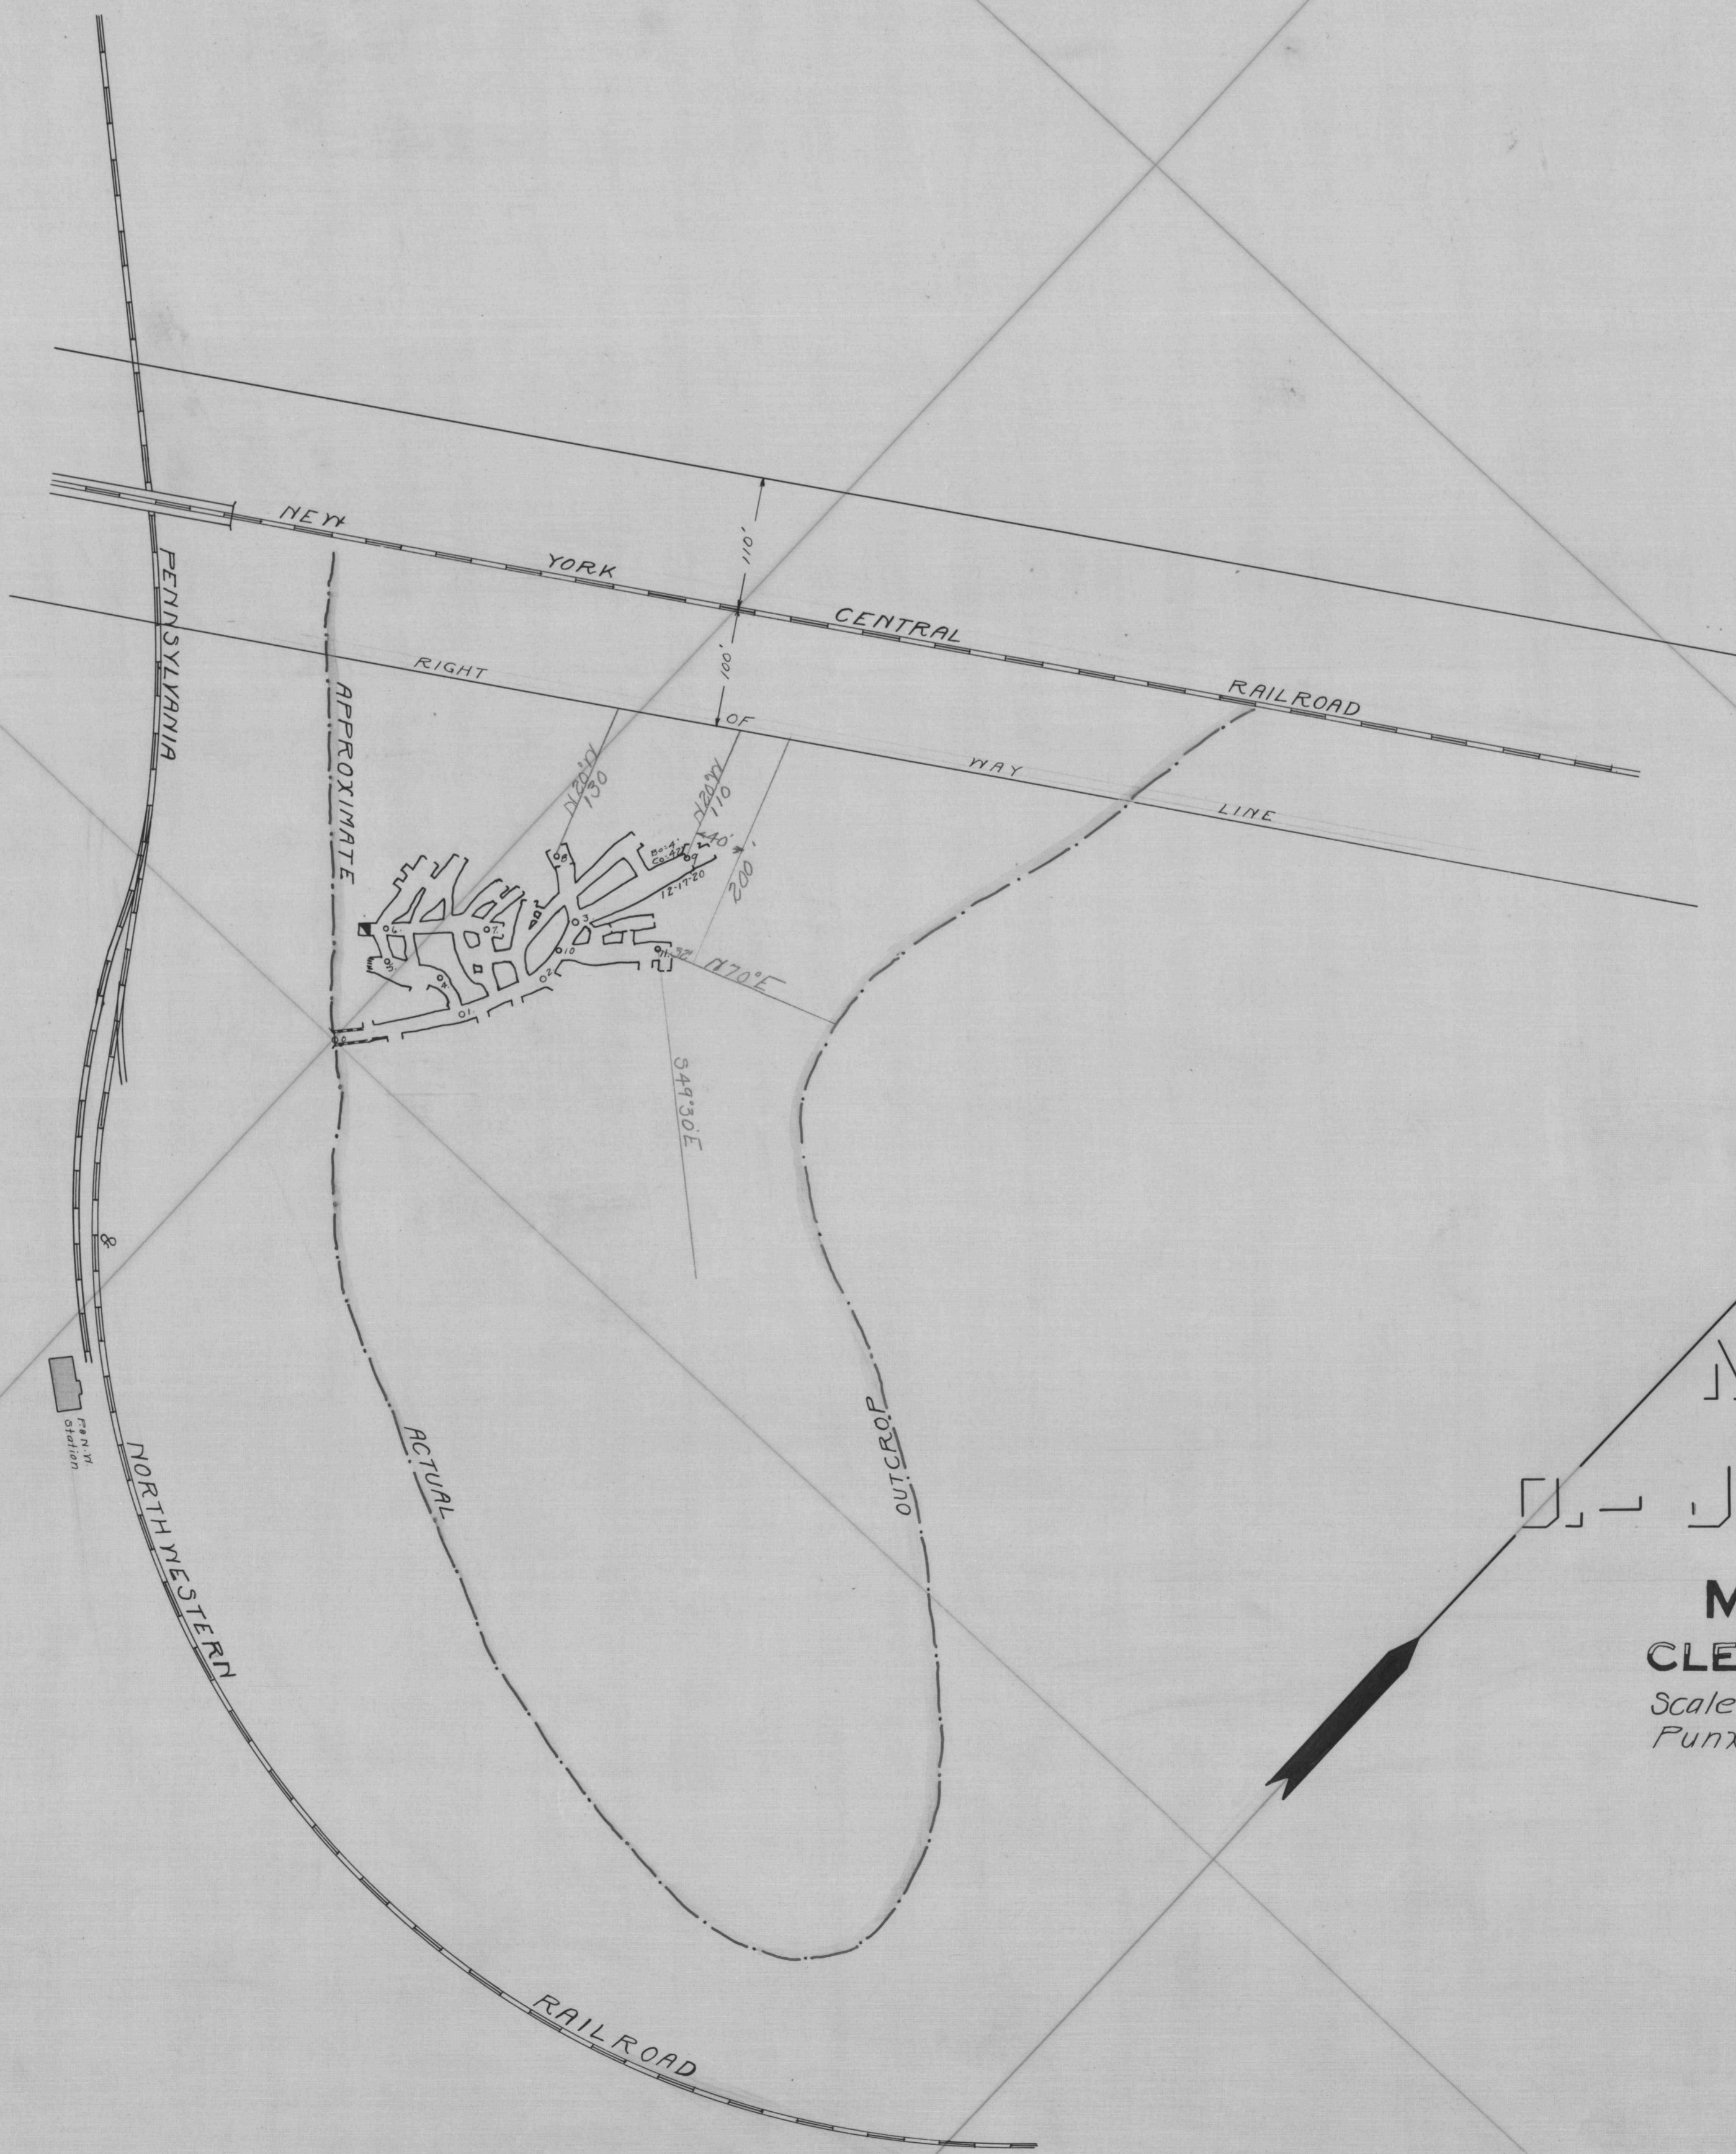

MAP OF
D. J. COAL CO.

M'GEE'S MILLS
CLEARFIELD CO., PA.

Scale 1 in. = 100 ft. H.M. Kanarr
Punxsutanney Pa. Eng'r.

12-17-1920