




PANTALL COAL CO.
 McGees Mills Clearfield Co., Pa.

SCALE 1 IN = 100 FT. H.M. KANARR ENGR.
 PUNXSUTAWNEY PA.

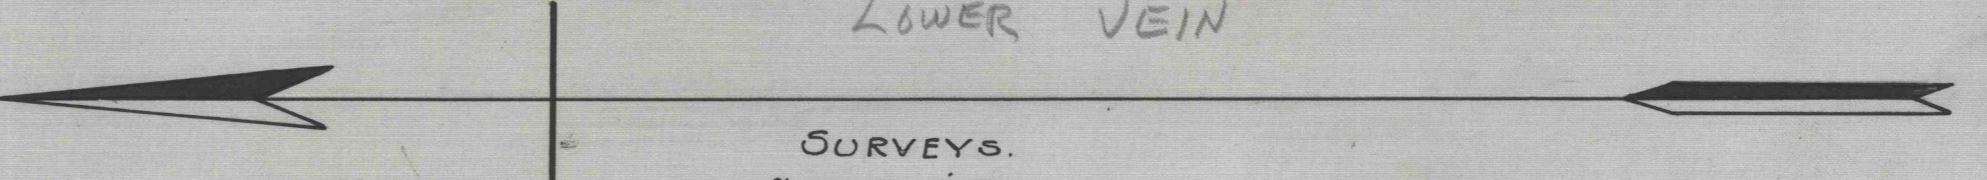

SURVEYS.
 Nov. 17, 1919.

4000.0 South

5000.0 South

6000.0 South

1000.0 East

1000.0 East

2000.0 East

3000.0 East

3000.0 East

1000.0 East