
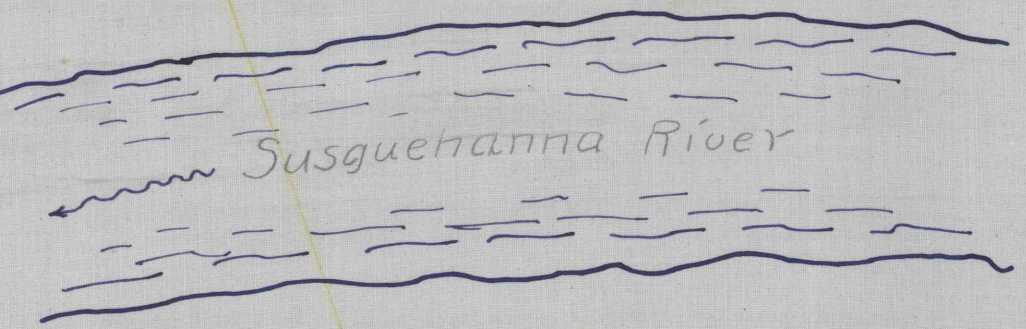


7000.0 East

6000.0 East

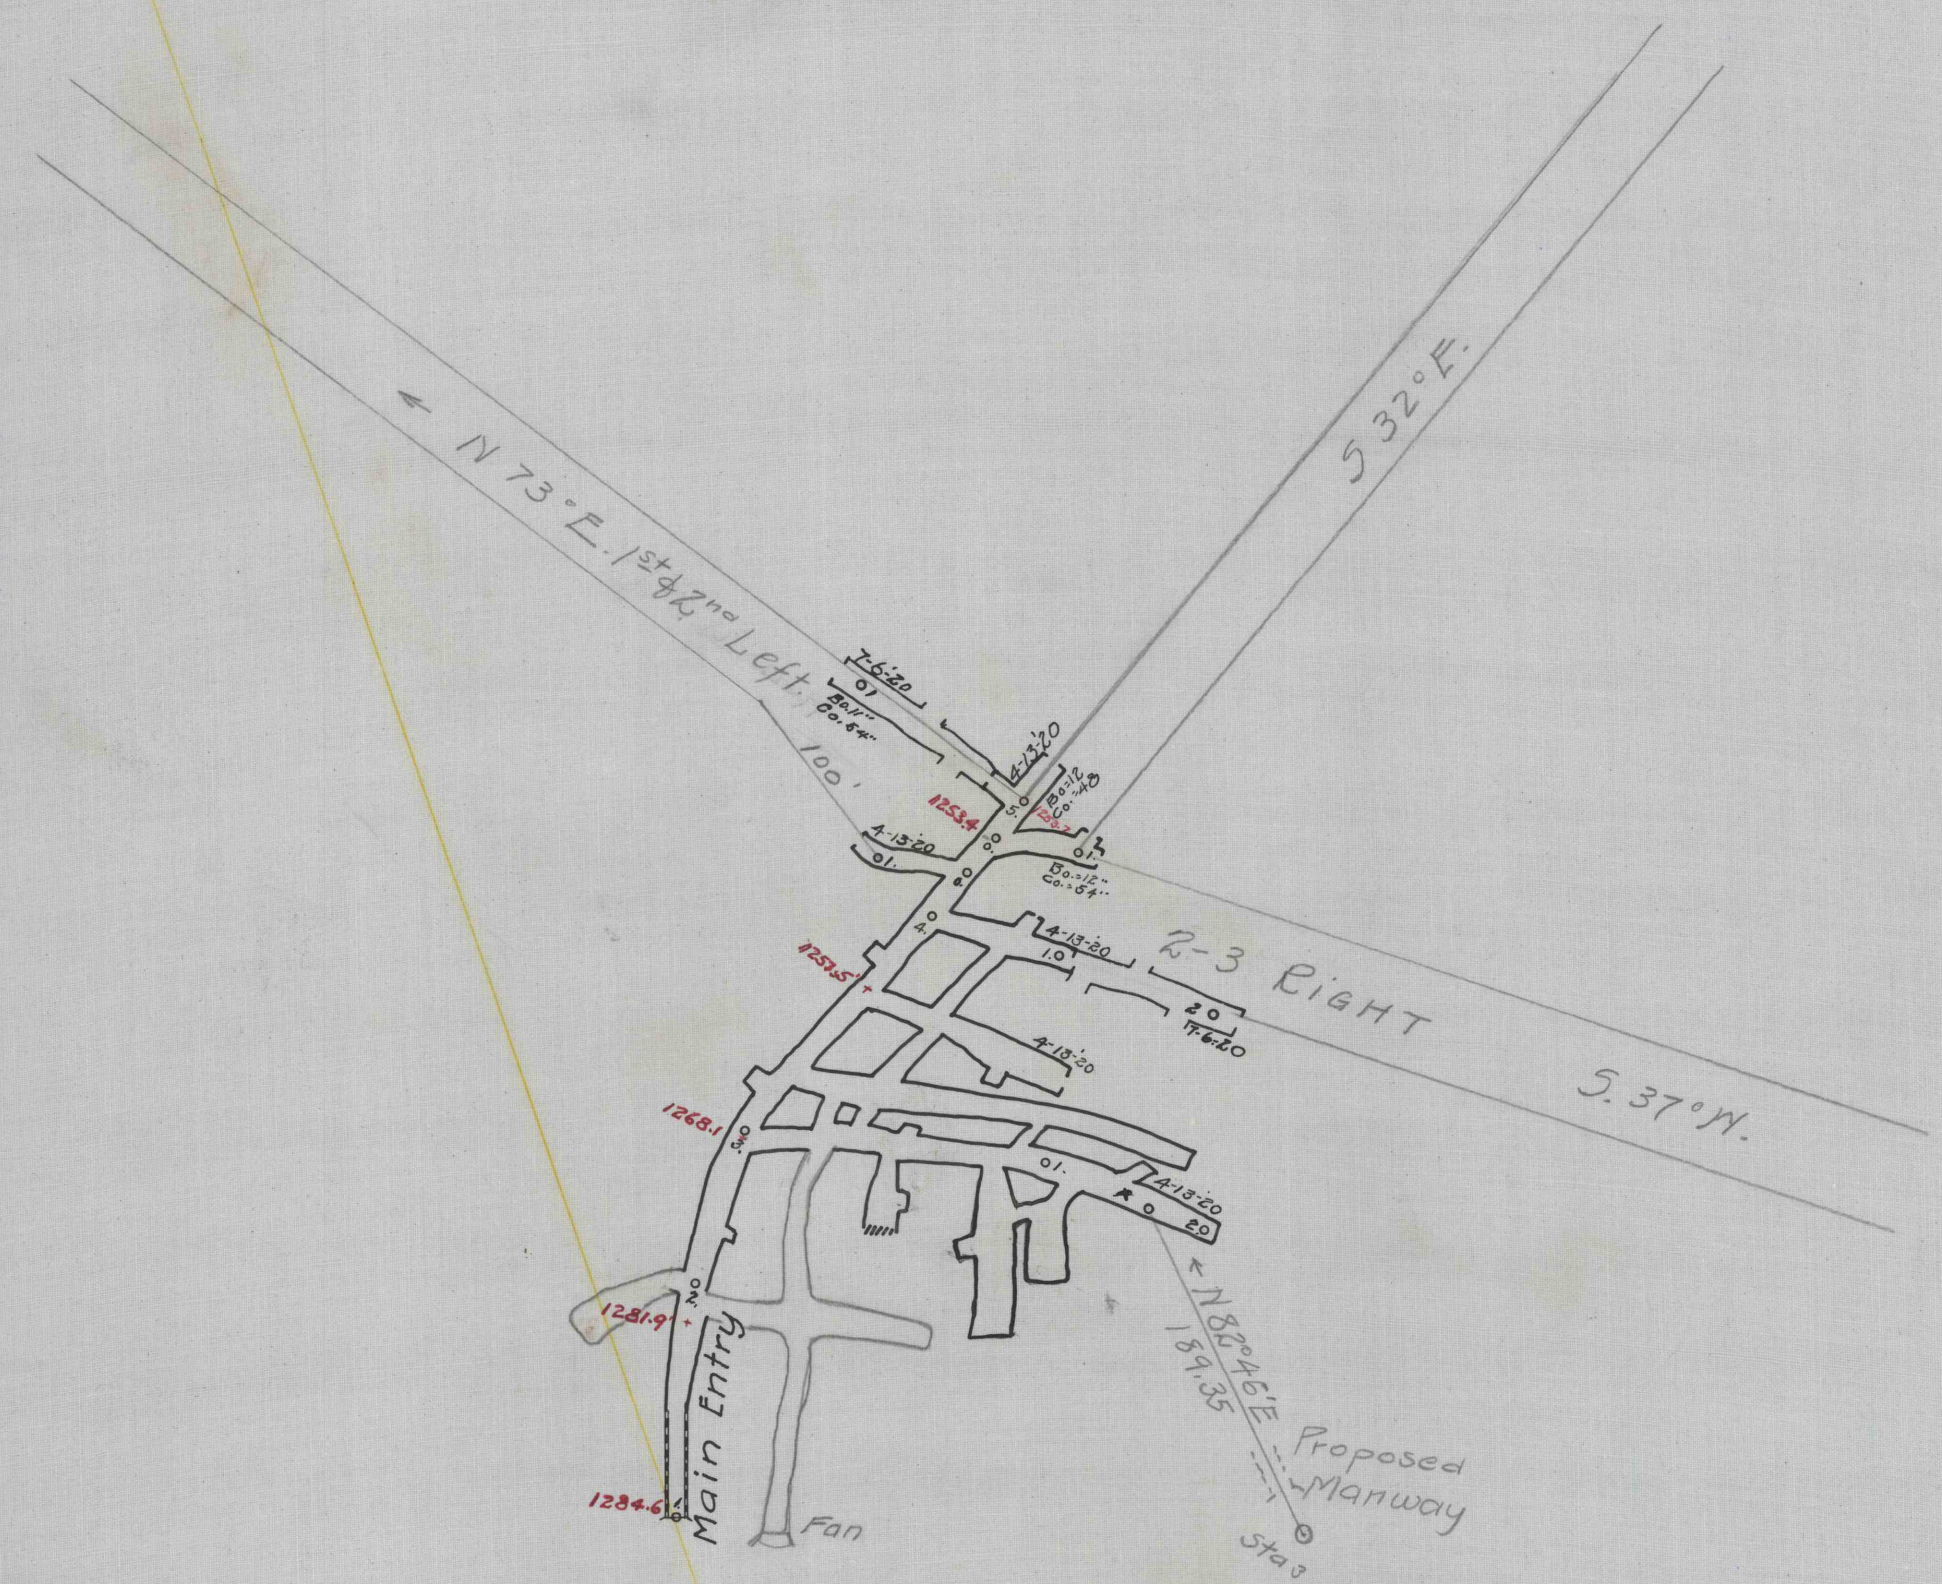

MINE MAP
OF
SOUTH BRANCH COAL CO.
M^oGEES, PA.

Scale 1"=100'
Pottsville, Pa., April 1920.

H. M. Kanarr
Engineer.

GE-88