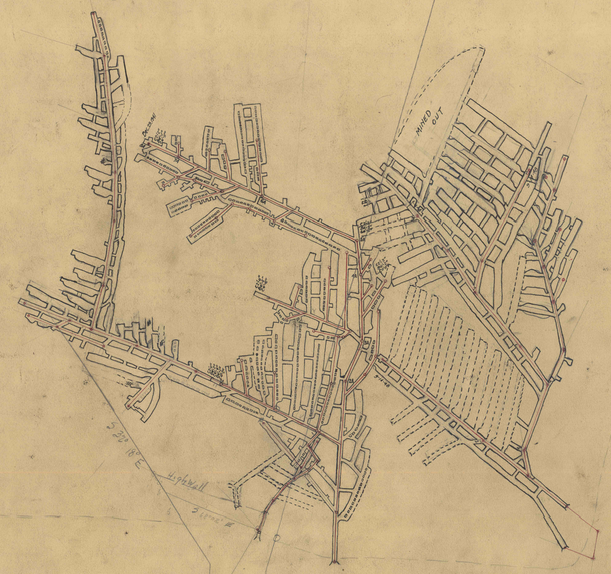
Highball
Street