


DATE OF SURVEY
 APR., 6, 1949 - Dec., 12, 1949
 Feb. 21, 1950
 July 24, 1950
 Jan. 23, 1951
 Sept. 13, 1952
 Feb. 16, 1953

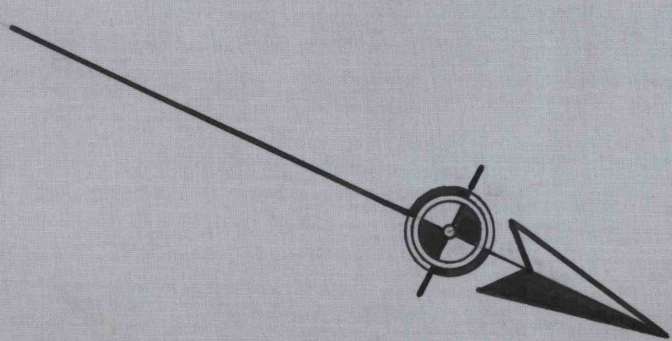

MINE MAP
P. & N. COAL CO.
 KEISTER MINE
 HUSTON TWP., CLEARFIELD COUNTY, PENN'A.
 SCALE 1" = 100' APRIL, 1949
 Walter J. Zimmerman, Engineer-Surveyor, Punxsutawney, Pa.