


87

MAP OF
LELAND No. 10 MINE
LELAND COAL MINING CO.
BETHLEHEM, PA.
Scale 1"=100'

N 25° 15' E 3127.63'

PAVING TRACT
129,308 M

HALE TRACT
104,400 M

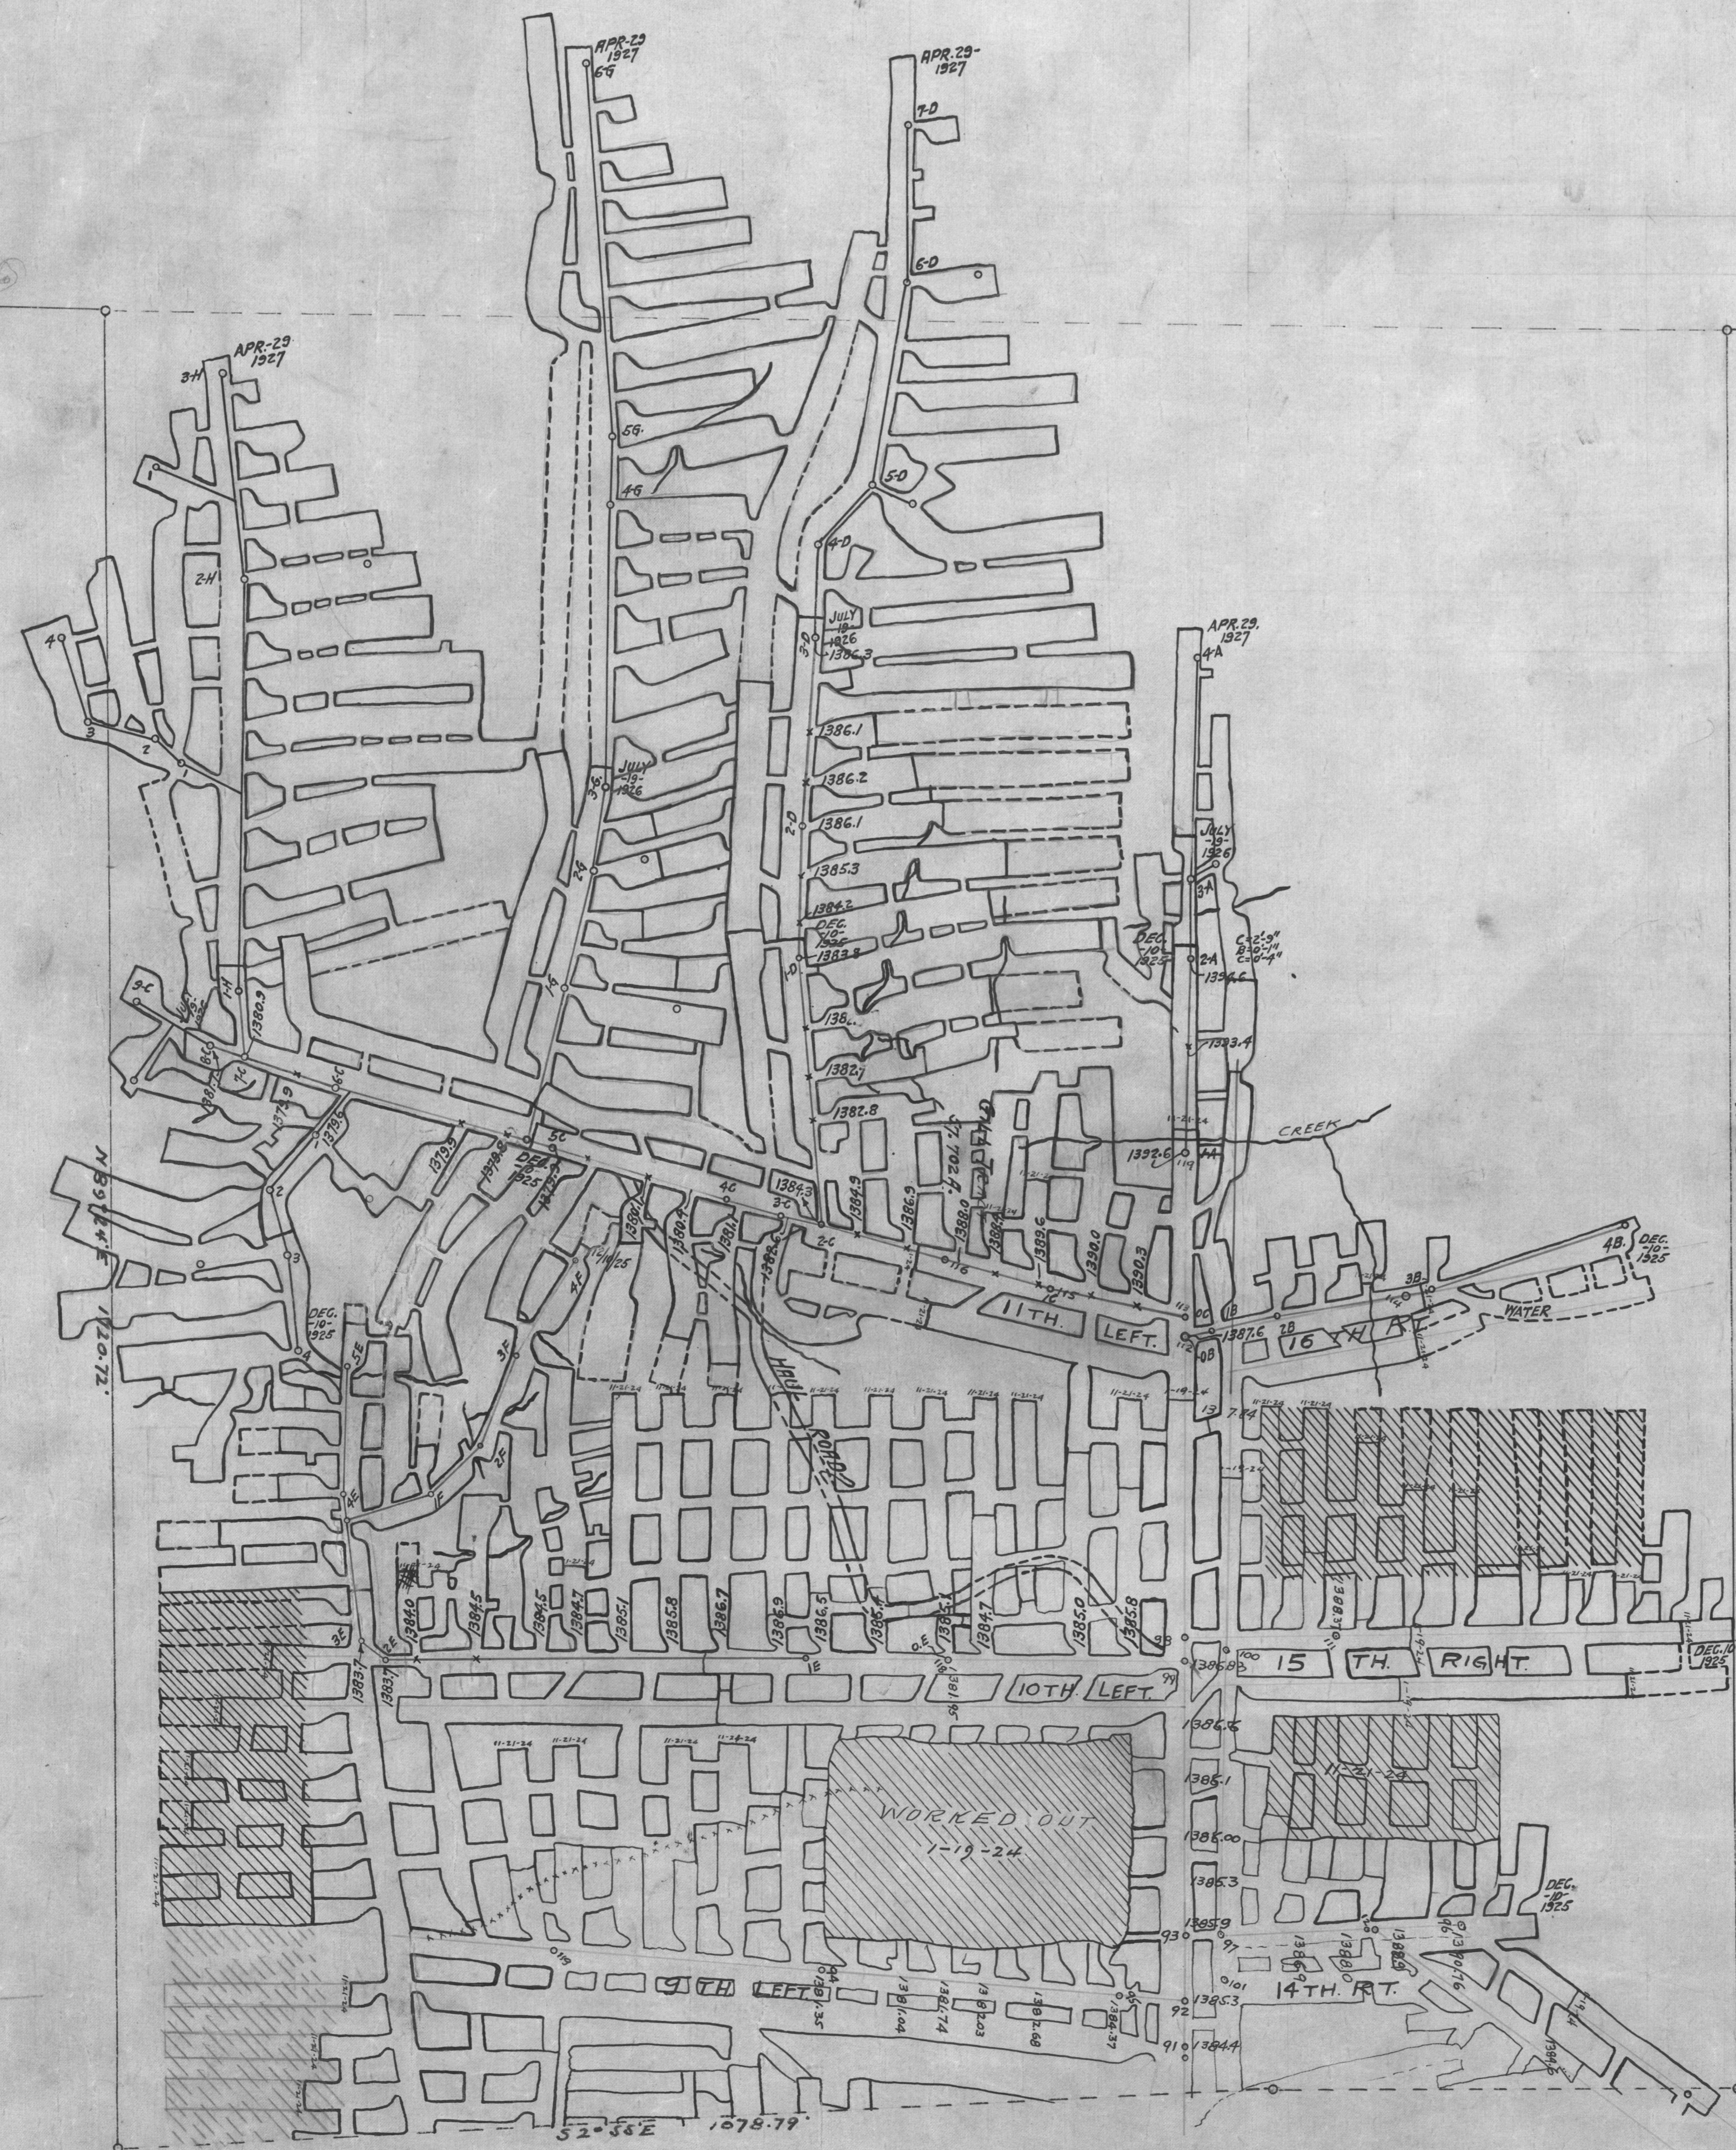

NOTE:-
 SURVEYS MADE IN THIS MINE SINCE
 NOV. 1924 ARE BASED ENTIRELY UPON
 SURVEYS MADE BY OTHER ENGINEERS
 AND RESPONSIBILITY FOR RELATION
 OF MINE WORKINGS TO LAND LINES AS
 SHOWN ON THIS MAP IS NOT ASSUMED
 BY UNDERSIGNED

W.C. Sullivan
 for T.S.P.

89
 96
 17

154
 49
 427