


LELAND GOAL MINING CO.
 MAP OF COAL LANDS
 AND
 MINE WORKINGS
 NEAR
 BEGGARIA, CLEARFIELD COUNTY, PA.
 SCALE: - 1" = 400'

W.A. SILLIMAN,
 MINING ENGR.
 ALTOONA, PA.

MINE WORKINGS REVISED TO [REDACTED]

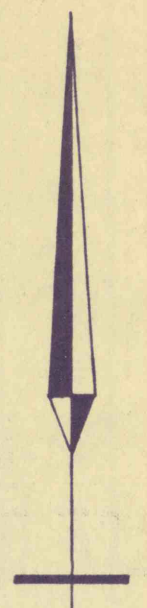

SAMUEL SEMPLE.

N89°34'E 1884.59
 50°08'E 1437.10
 SHOFF HRS. 47
 66.08 AS.
 WILLIAM SMITH-COAL
 ANDREW SHOFF TRACT.
 TOTAL AREA 115.64 AS.

D. K. RAMEY

LEMUEL SEMPLE - SURFACE
 SEMPLE HRS. - COAL.

MRS. G. G. GOPENHAVER,
 TRACT.
 AARON EMLER - SURFACE,
 COAL LEASED TO
 WILLIAM SMITH.

LELAND GOAL MINING CO.
 - 49.58 AS.
 COAL

MINED OUT.

JOHN MECOY
 259 AS.

FRANK MECOY
 3177.69

P. FLYNN TRACT
 104.86 AS.

MINED OUT.

MINED OUT.

BERWIND WHITE COAL MINING CO.

A. C. SMITH TRACT
 JOHN KOLLAR (SUR)
 47.92 AS.

JOHN LITZ HRS.

P. O'SHELL
 SUR.

586.48 W
 1062.84
 POST
 303.21
 187.91
 N67°13'W
 696.81
 POST
 50°47'E
 1407.04
 BERWIND WHITE
 COAL MINING CO.

IRVIN

