


DATE	AFFECTED AREA		BACKFILL AREA		RESIDUAL AREA
	LETTER	INCREMENT	CUMULATIVE	INCREMENT	
DEC. 23, 1964	A	26.21	26.21	10.91	15.30
JAN. 10, 1965	B	27.40	53.61	—	42.70
MAY 5, 1966	—	—	53.61	7.56	35.14
NOV. 7, 1968	C	21.50	75.11	41.62	15.02
DEC. 22, 1969	D	46.50	121.61	—	61.52
APR. 9, 1970	—	—	121.61	46.58	14.94
JULY 27, 1971	E	35.60	157.21	—	50.54
OCT. 26, 1972	F	11.40	168.61	37.84	24.10
MAR. 16, 1973	G	1.30	169.91	25.40	—

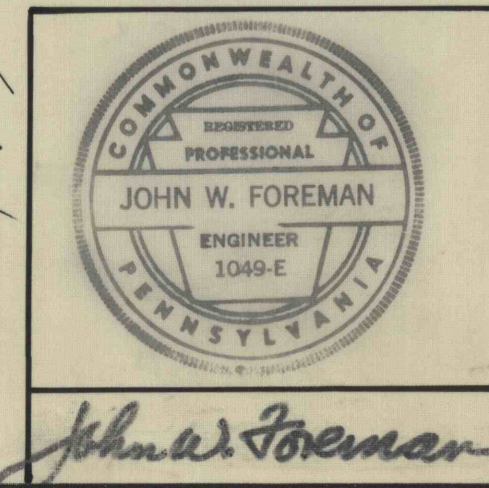

**C. E. POWELL COAL CO.**  
 BITUMINOUS COAL STRIPPING OPERATIONS  
 SITUATE IN  
 CHEST TWP, CAMBRIA CO. & CHEST TWP, CLEARFIELD CO., PA.

SCALE: 1" = 400'  
 DATE: NOV. 12, 1968  
 CONSULTING ENGINEERS: GWIN, DOBSON & FOREMAN, INC., ALTOONA, PENNSYLVANIA