


**LEGEND**



FEE COAL  
GROUP 1, 1946 LEASE  
GROUP 2, 1946  
TRACT 1, 1951  
TRACT 3, 1951  
LEASED TO COON RUN COAL CO.

★ DIAMOND DRILL HOLES

Map No.	Res. No.	R.H.C.M.C.
6	9	R.H.C.M.C.
10	10	R.H.C.M.C.
11	11	R.H.C.M.C.
17	17	R.H.C.M.C.
19	19	R.H.C.M.C.
20	20	R.H.C.M.C.
23	23	R.H.C.M.C.
24	24	R.H.C.M.C.
38	38	R.H.C.M.C.
39	39	R.H.C.M.C.
40	40	R.H.C.M.C.
41	41	R.H.C.M.C.
42	42	R.H.C.M.C.
43	43	R.H.C.M.C.
44	44	R.H.C.M.C.
45	267	C.T.C.C.
46	268	C.T.C.C.
47	264	C.T.C.C.
48	265	C.T.C.C.
49	263	C.T.C.C.
50	251	C.T.C.C.
51	248	C.T.C.C.
52	242	C.T.C.C.
53	225	C.T.C.C.
54	285	C.T.C.C.
55	260	C.T.C.C.
56	279	C.T.C.C.
57	37	R.H.C.M.C.
58	170	C.T.C.C.
59	247	C.T.C.C.
60	164	C.T.C.C.
61	245	C.T.C.C.
62	185	C.T.C.C.
63	266	C.T.C.C.
64	271	C.T.C.C.
65	249	C.T.C.C.
66	202	C.T.C.C.
67	210	C.T.C.C.
68	193	C.T.C.C.
69	179	C.T.C.C.

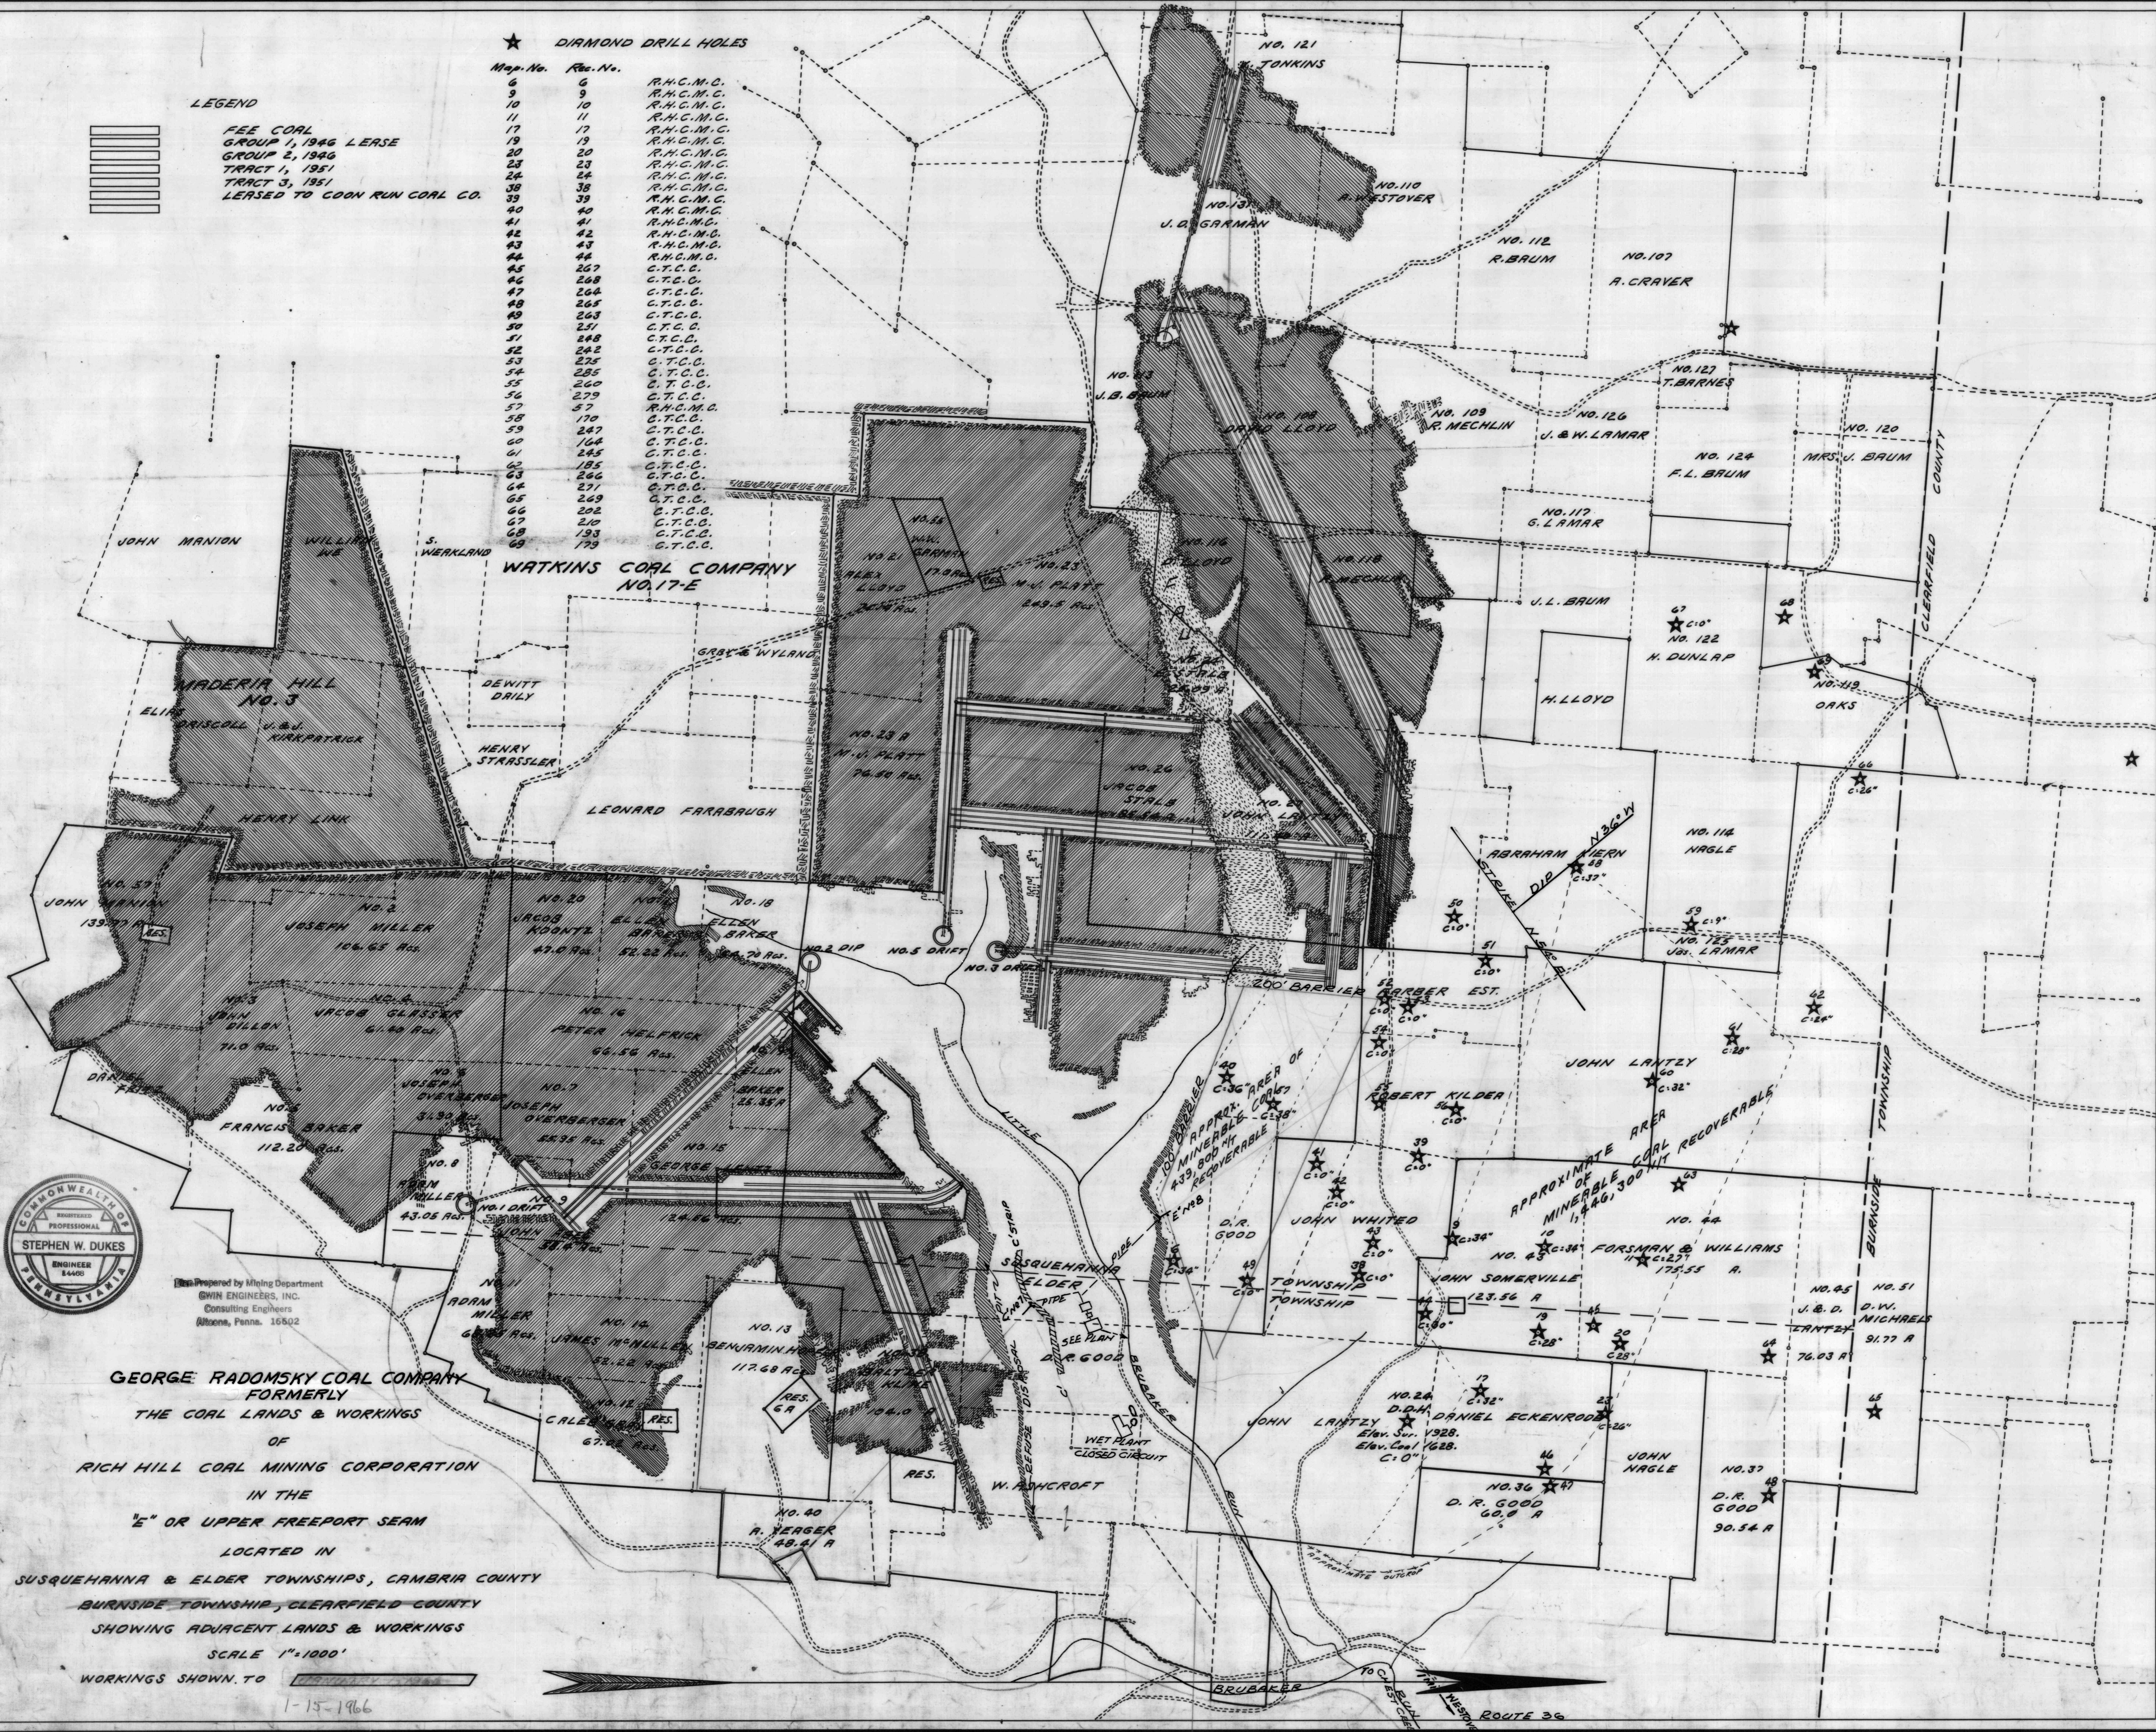

Prepared by Mining Department  
GWIN ENGINEERS, INC.  
Consulting Engineers  

**GEORGE RADOMSKY COAL COMPANY**  
FORMERLY  
THE COAL LANDS & WORKINGS  
OF  
RICH HILL COAL MINING CORPORATION  
IN THE  
"E" OR UPPER FREEPORT SEAM  
LOCATED IN  
SUSQUEHANNA & ELDER TOWNSHIPS, CAMBRIA COUNTY  
BURNSIDE TOWNSHIP, CLEARFIELD COUNTY  
SHOWING ADJACENT LANDS & WORKINGS  
SCALE 1"=1000'  
WORKINGS SHOWN TO

1-15-1966