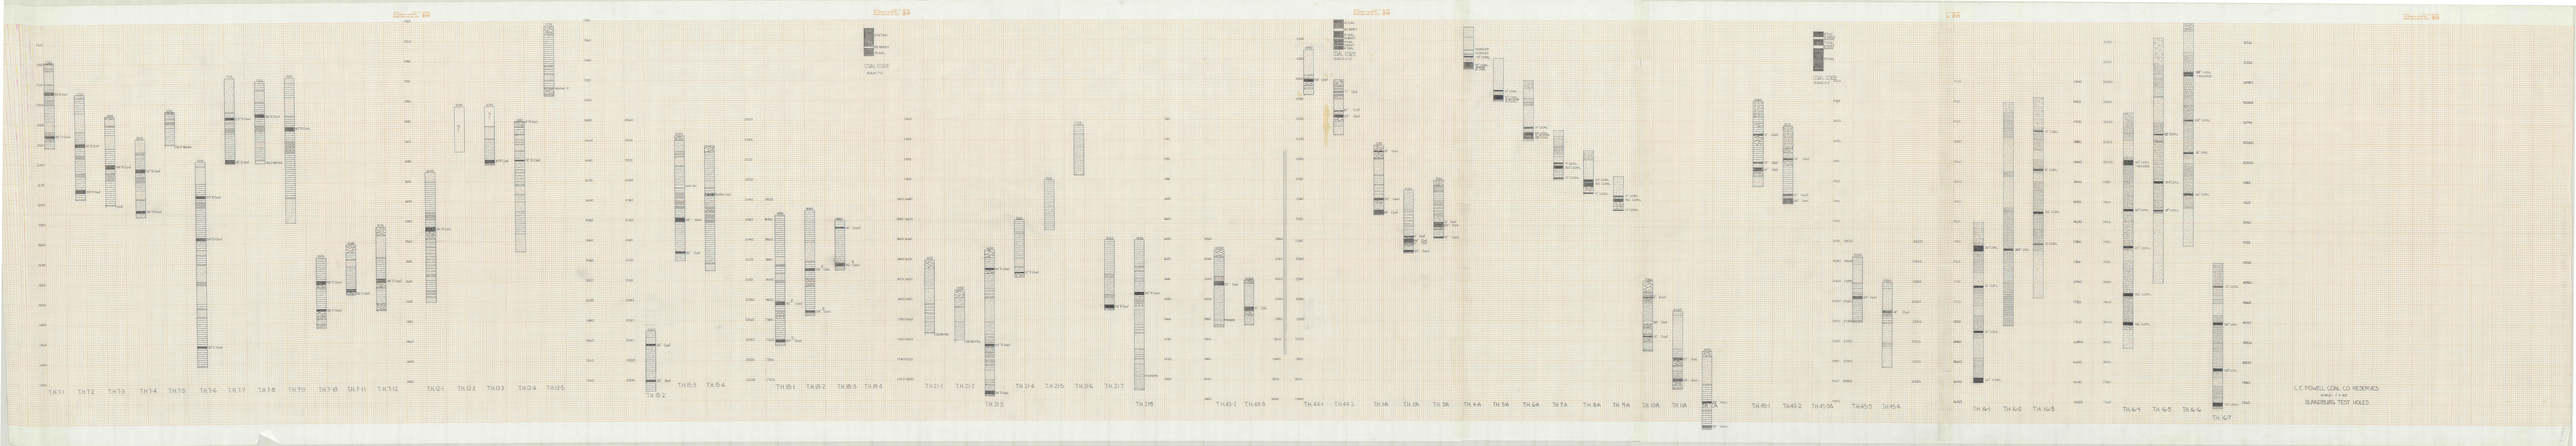
COAL CODE
C.C. POWELL COAL CO RESERVES
BLANDBURG TEST HOLES