


LANDS, MINES & DRILL HOLES
QUEENS RUN FIRE BRICK CO.
QUEENS RUN, CLINTON CO

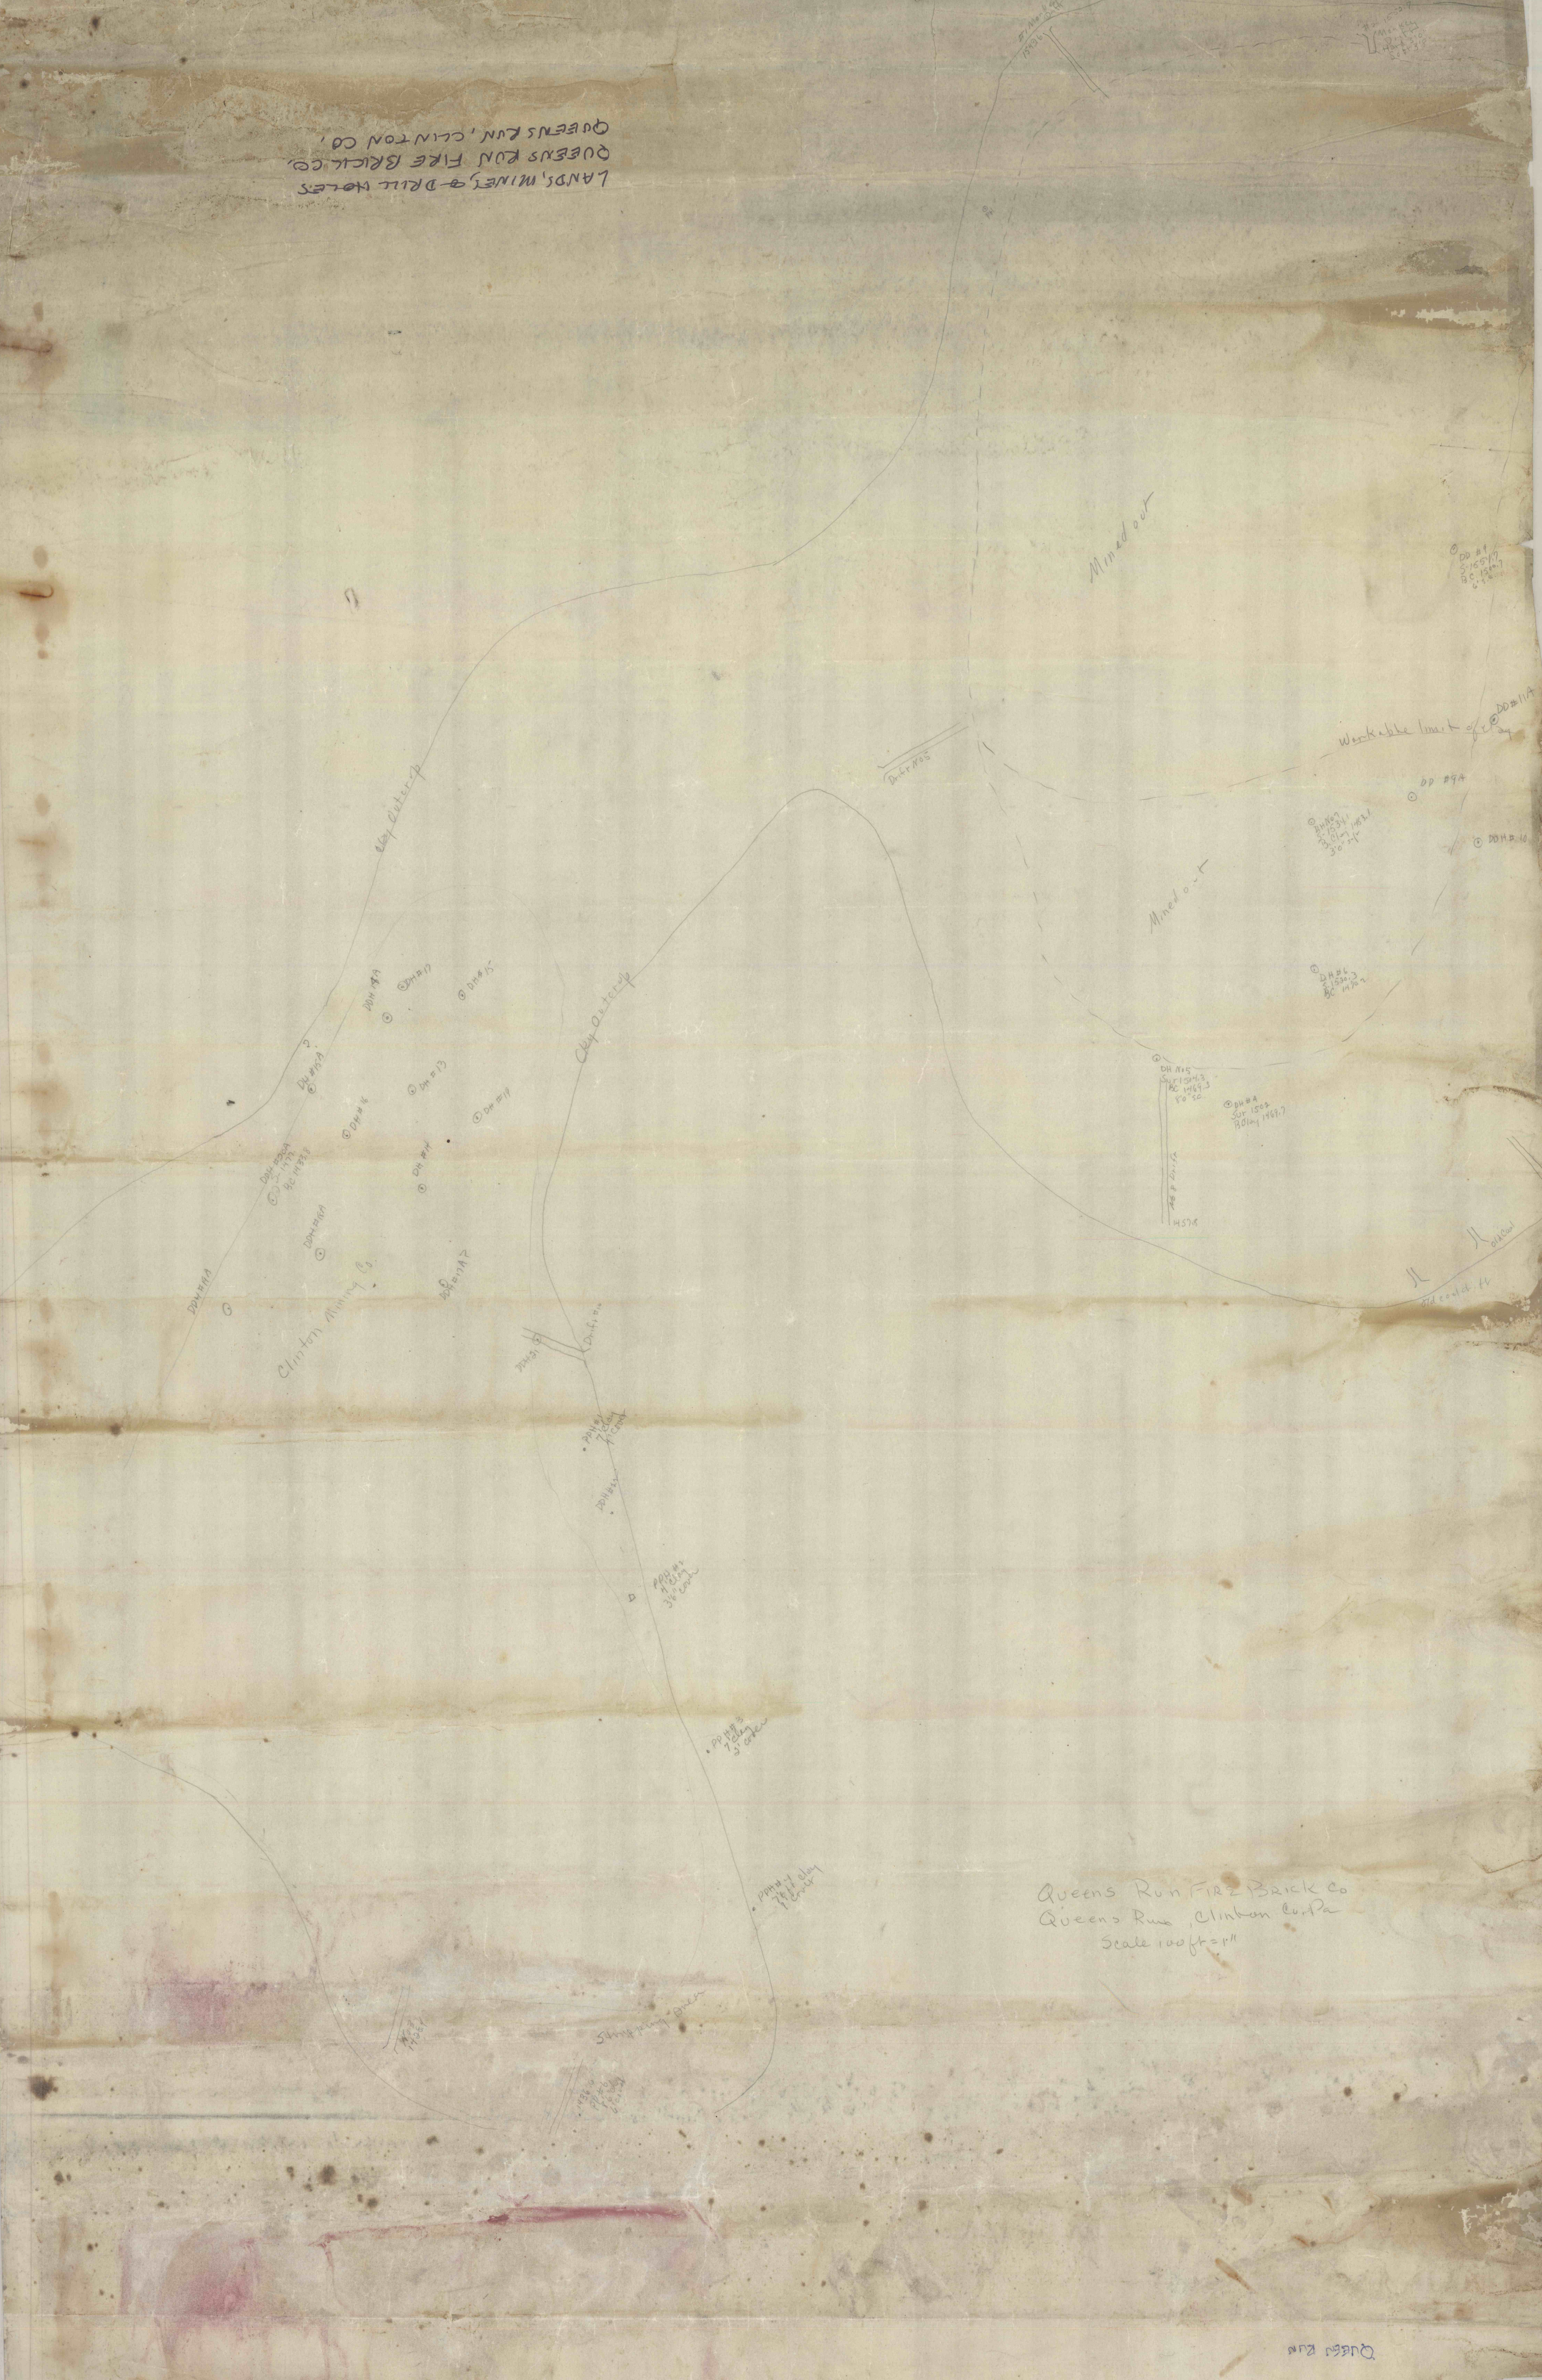

Queens Run FIRE BRICK CO
Queens Run, Clinton Co, Pa
Scale 100ft = 1"

Queens Run