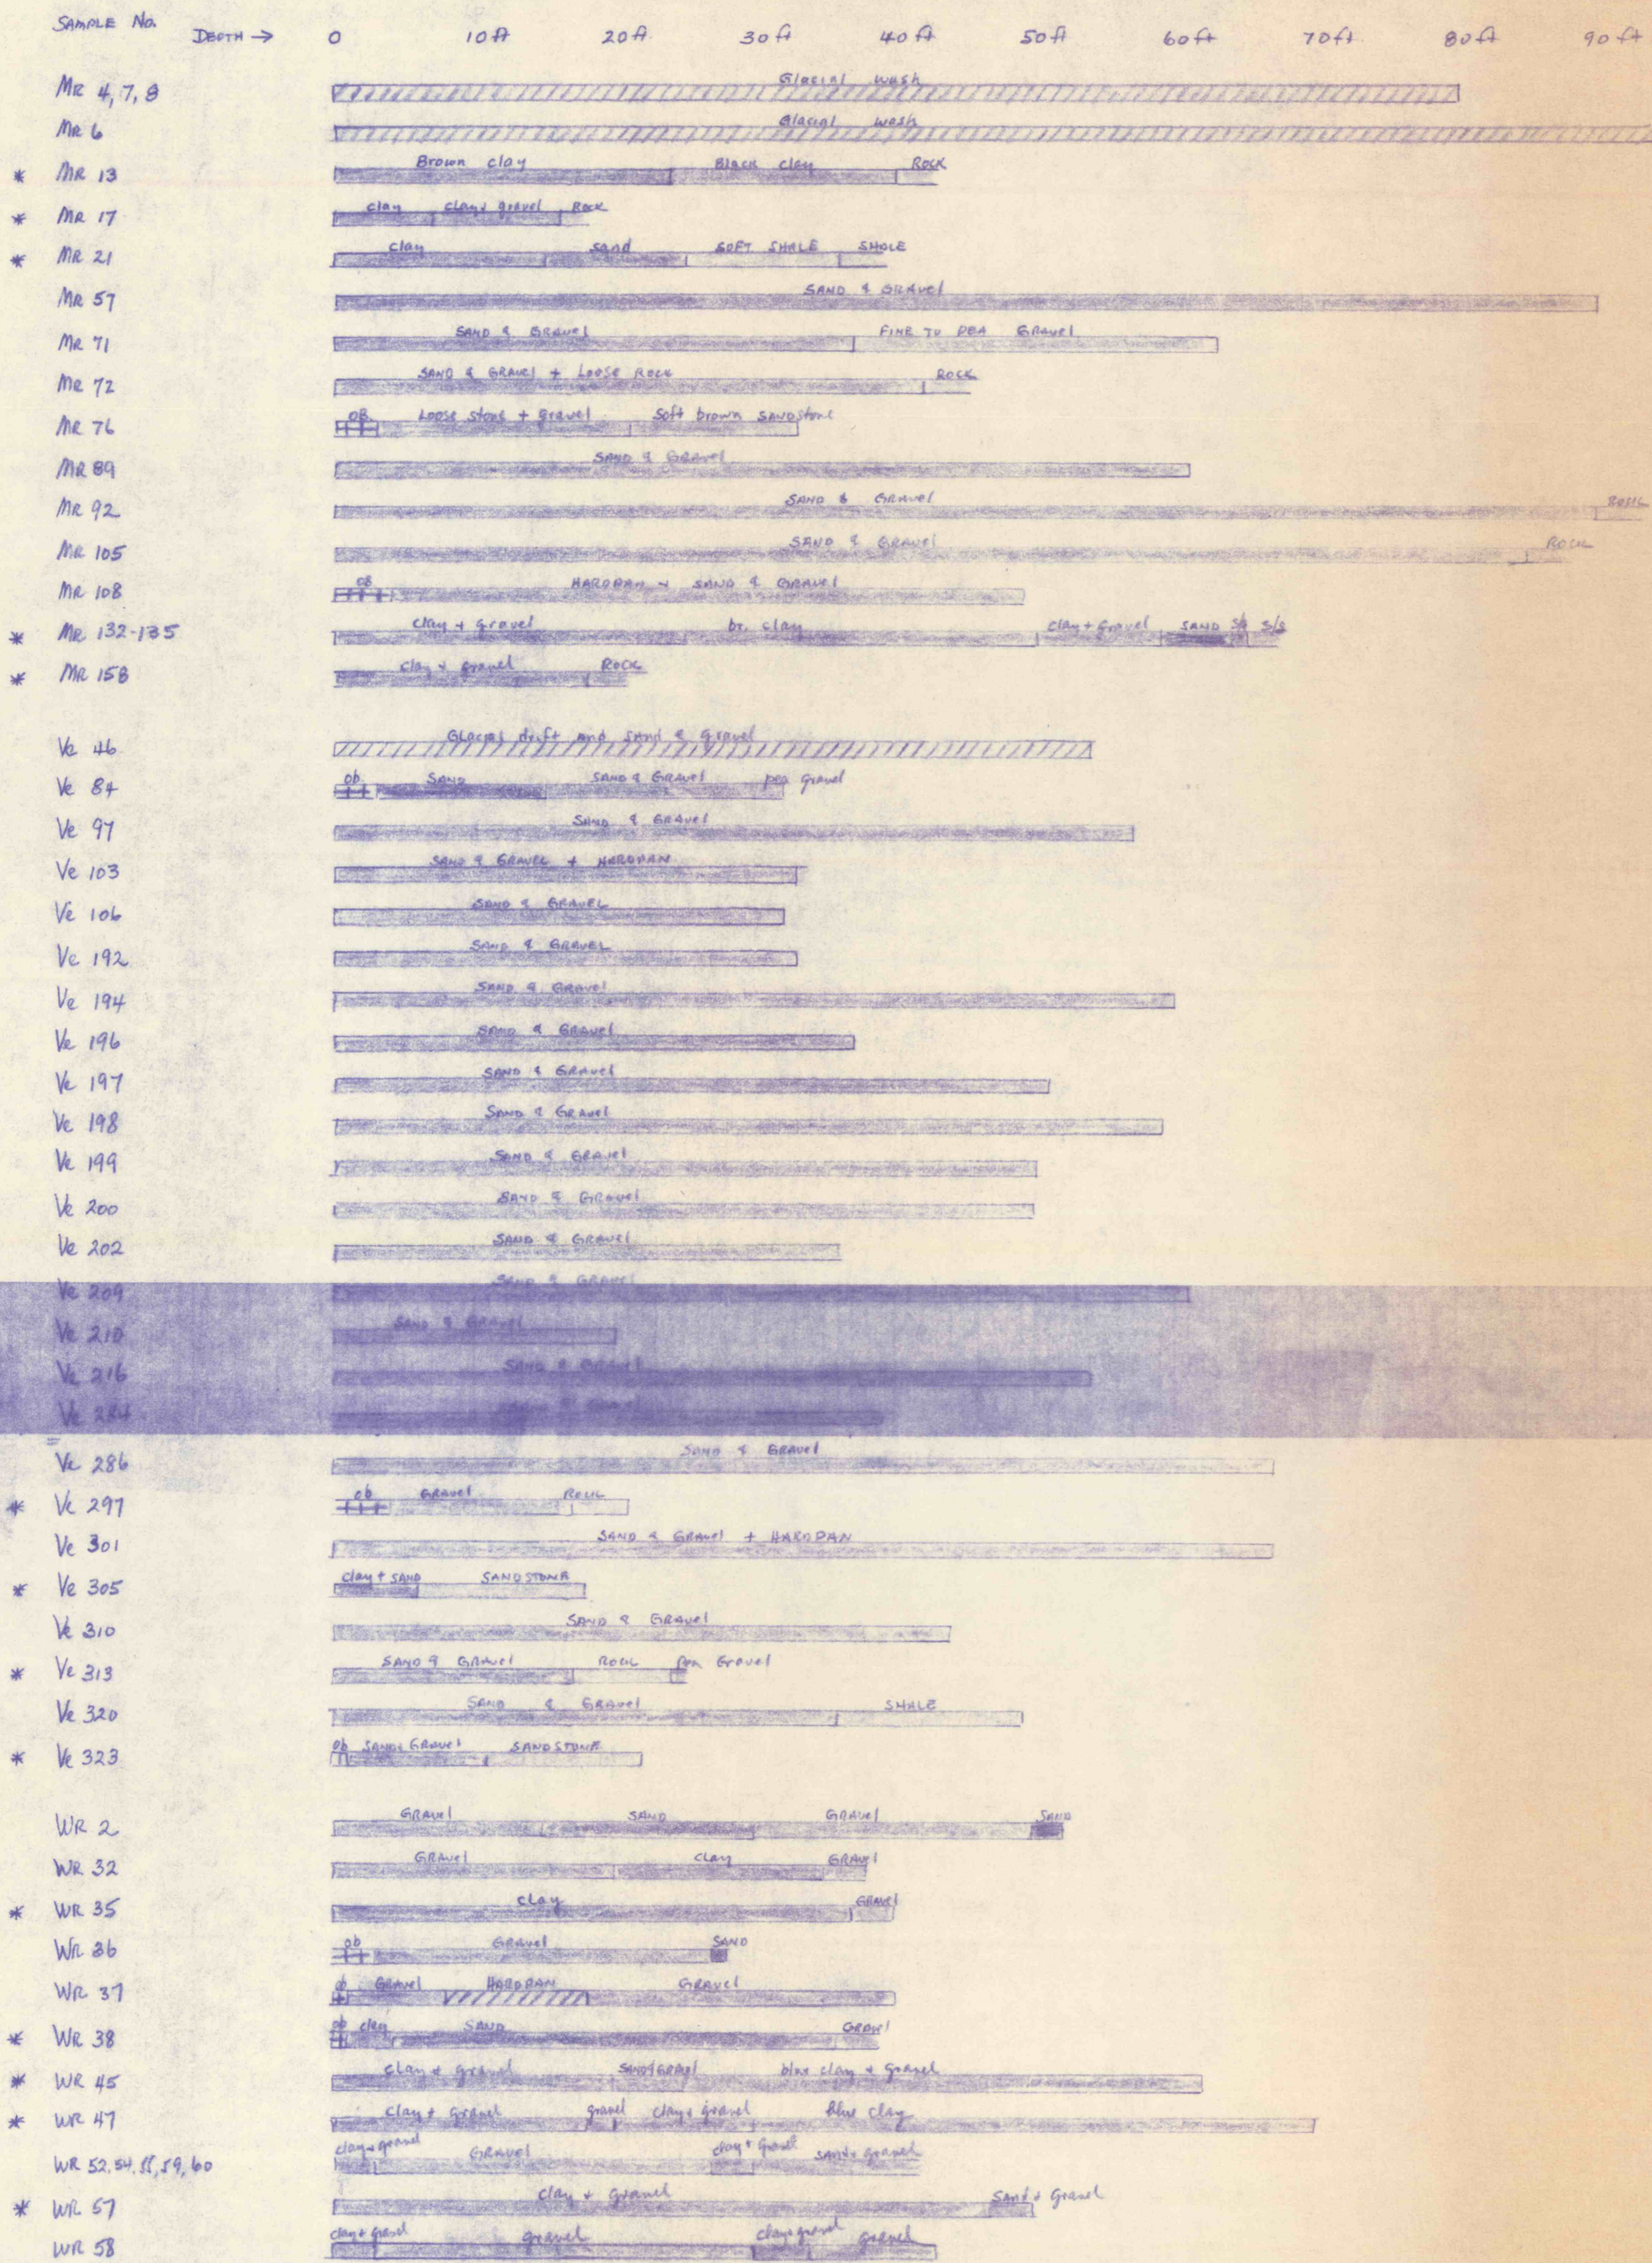


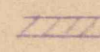
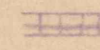

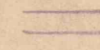
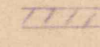


TABLE 6
GRAPHIC LOGS OF WATER WELLS (REFERENCE: FILE OF PA. Geol. Survey, HARRISBURG, PA.)



COLOR LEGEND

-  Clay, clay + gravel, clay + sand, etc.
-  Sand + gravel (quality unknown)
-  Glacial wash, glacial drift and sand + gravel
-  Overburden
-  Sand
-  Rock (shale, sandstone, etc.)
-  Hardpan