

GENERAL MAP  
OF THE  
DENTS RUN COAL FIELD

ELK COUNTY, PENNA.

Scale: One inch = 1000 Feet



Office of  
E. V. d'Inwilliers, Geologist & Mining Engineer,  
518 Walnut St. Phila., Pa.

DECEMBER 1914

Emery Lands  
Area underlain by Upper Coal Bed; now being mined  
" " " Lower " " 185± below Upper Bed.

COAL SECTIONS: LOWER SEAM

Scale: 1" = 2 Feet

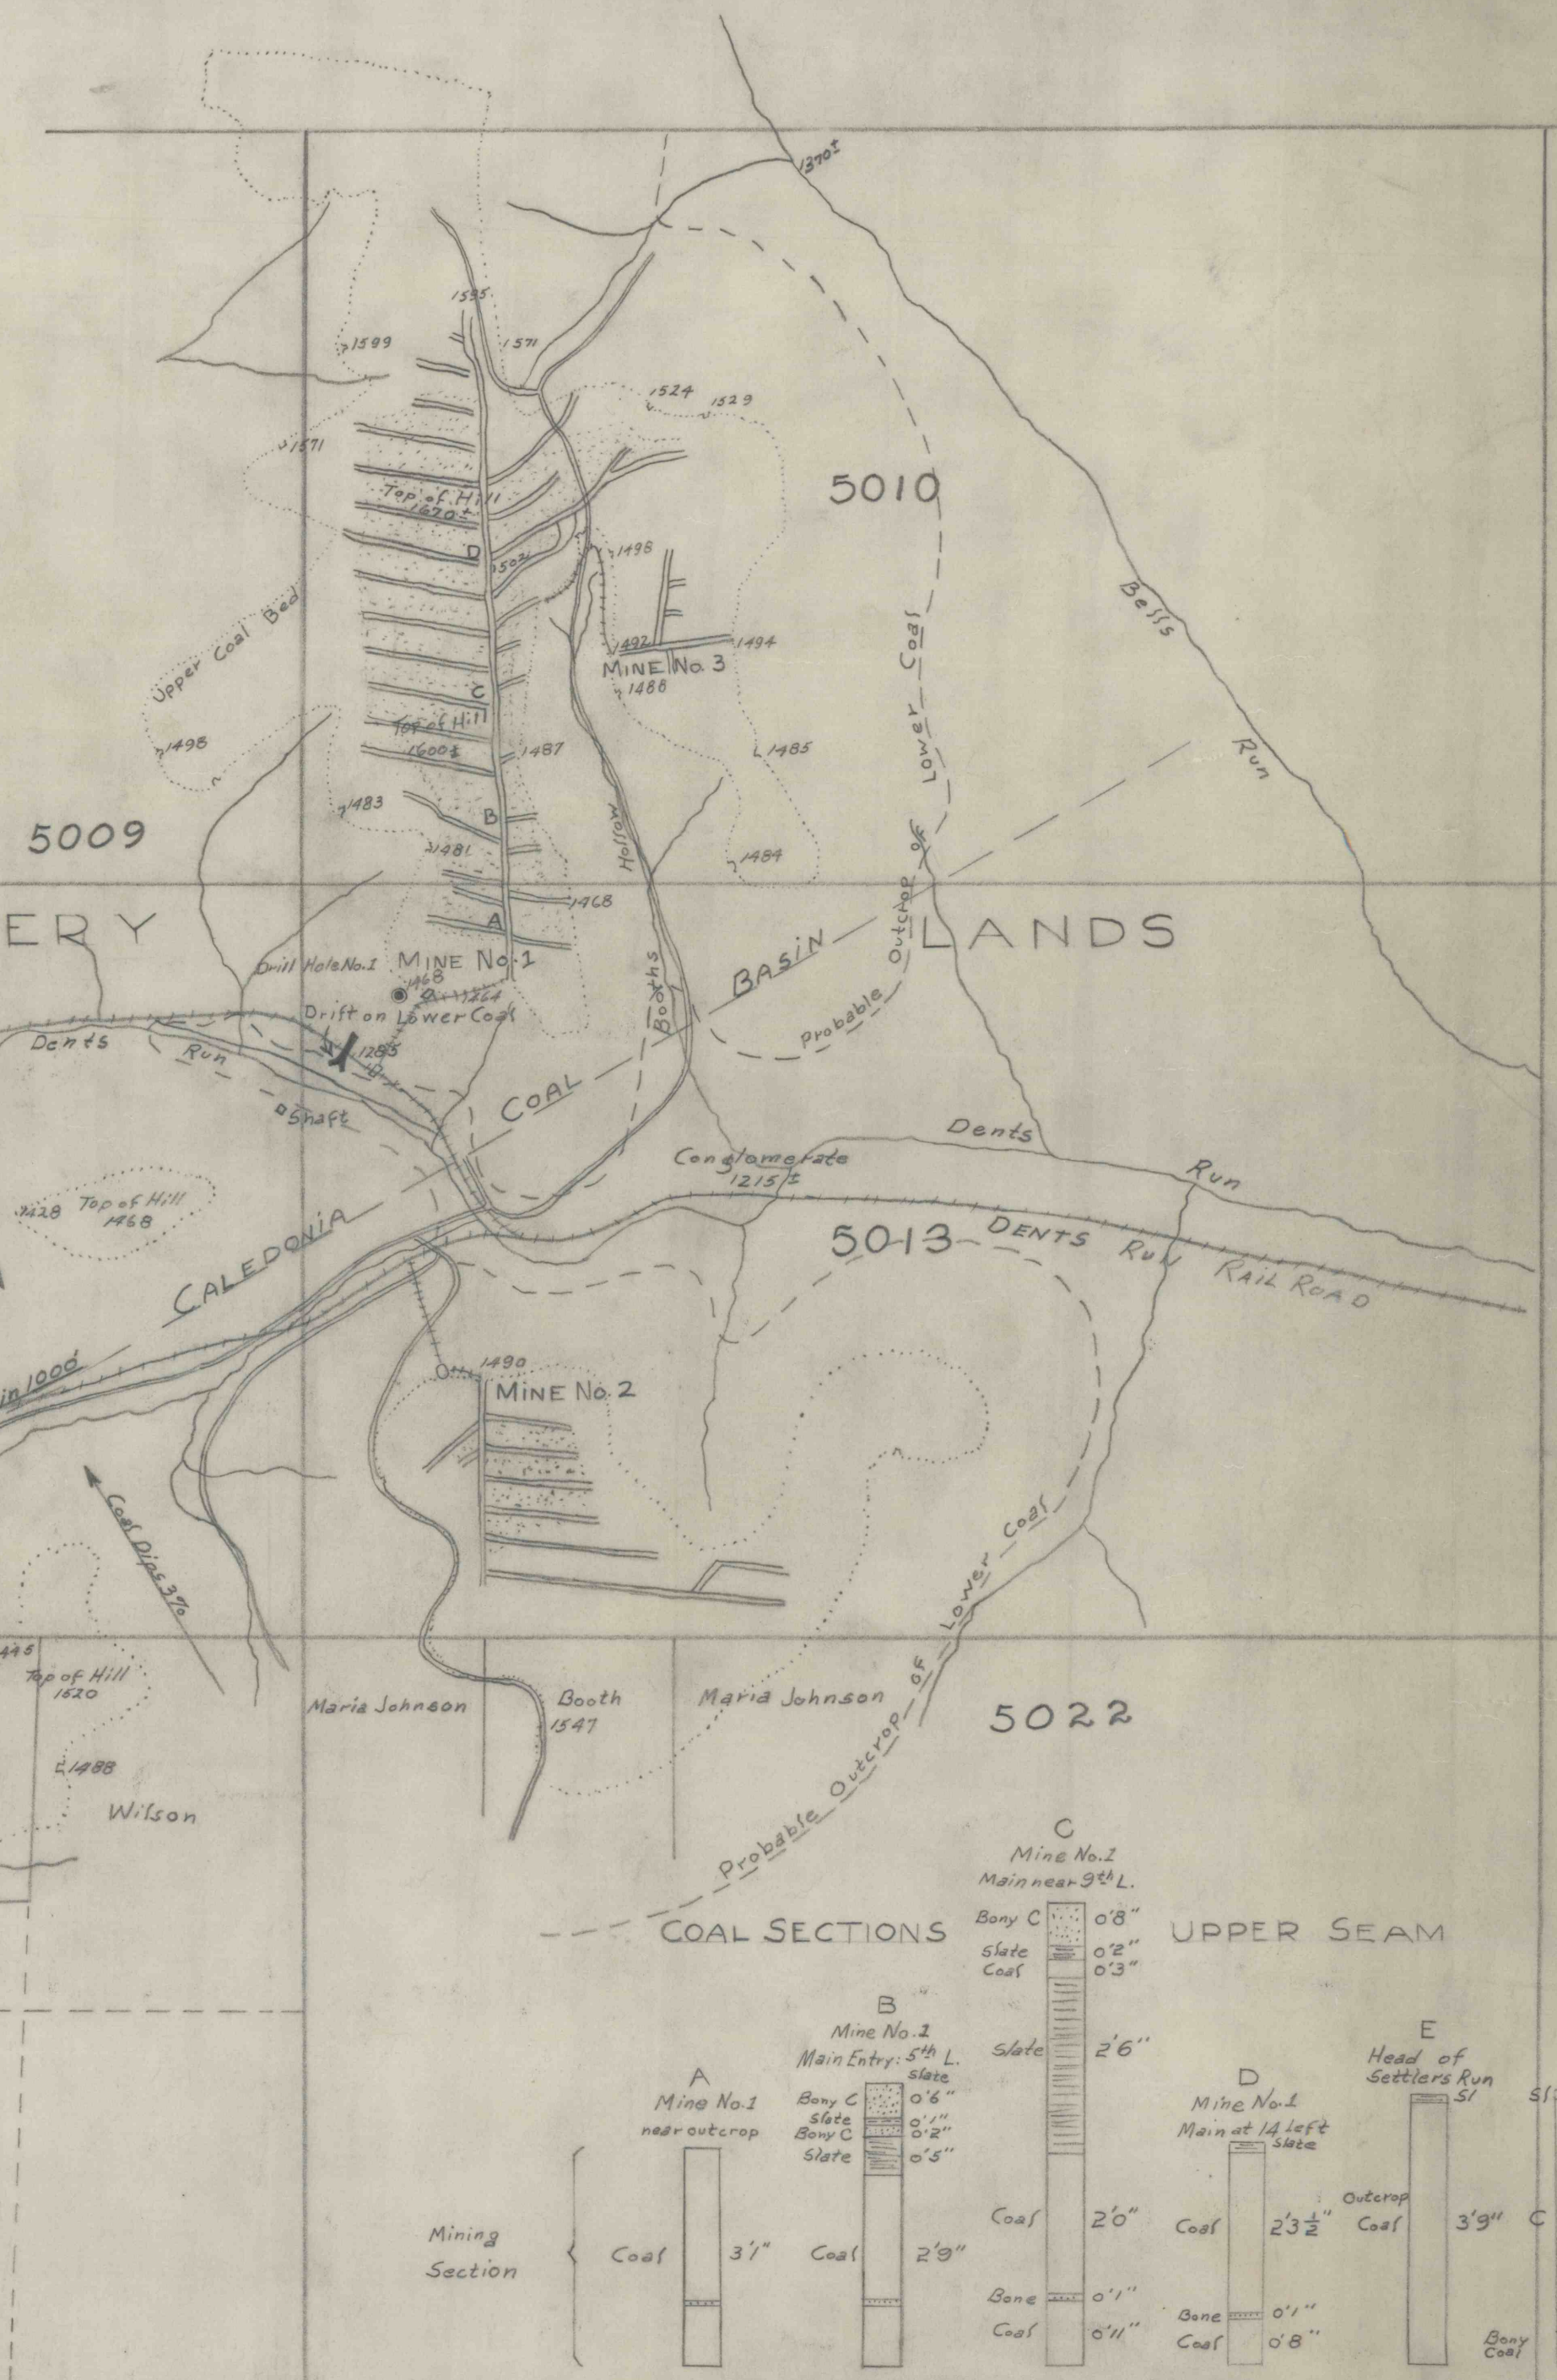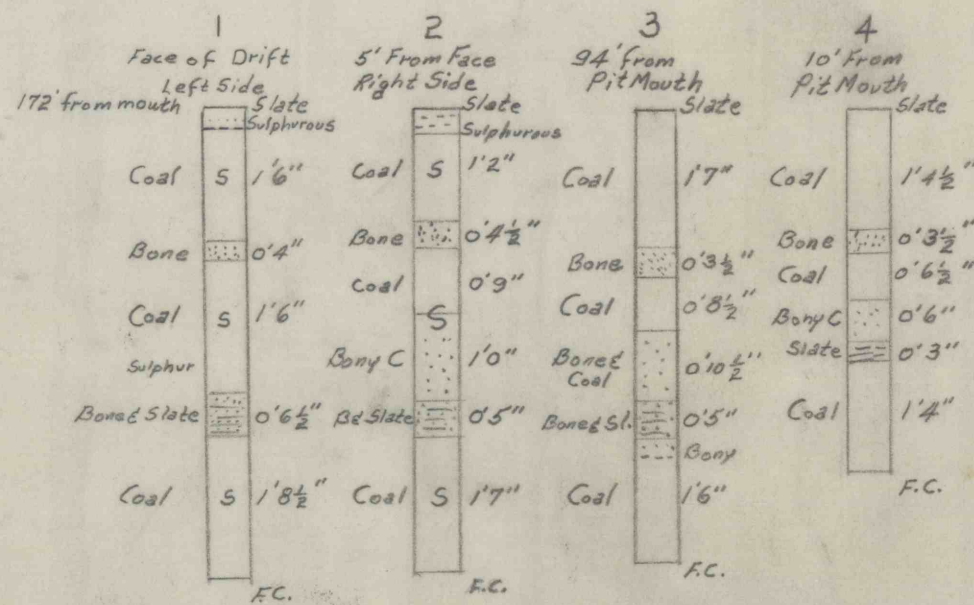

Note: Section F is the average of 5 new openings on Settlers Run