



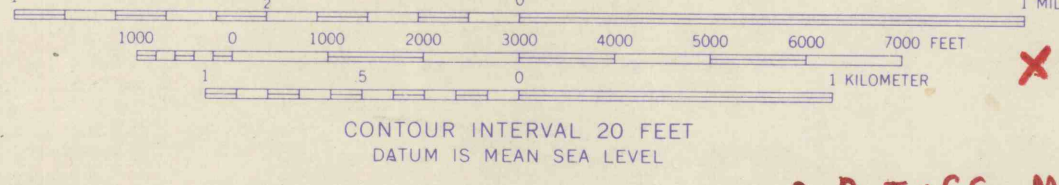


Lh 1
E-48"
D-6"
C-30"
B-24"
A-36"
Mh 8
bone-24"
coal

Mapped, edited, and published by the Geological Survey
Control by USGS and USC&GS
Topography by photogrammetric methods from aerial photographs
taken 1966. Field checked 1967
Polyconic projection. 1927 North American datum
10,000-foot grid based on Pennsylvania coordinate system, south zone
1000-meter Universal Transverse Mercator grid ticks,
zone 17, shown in blue
Fine red dashed lines indicate selected fence and field lines where
generally visible on aerial photographs. This information is unchecked
Areas covered by dashed light-blue pattern
are subject to controlled inundation

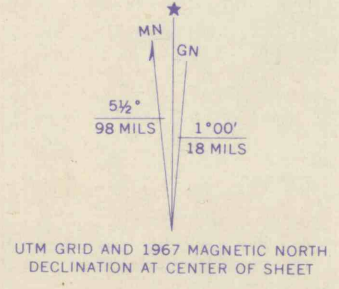

X PT463 M66
1973

D2463 M6
1926

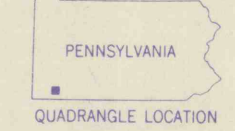

ROAD CLASSIFICATION
Primary highway, all weather, Light-duty road, all weather,
hard surface, improved surface,
Secondary highway, all weather, Unimproved road, fair or dry
hard surface, weather

U.S. Route State Route

OHIOPYLE, PA.
SW 1/4 CONFLUENCE 15' QUADRANGLE
N3945-W7922 5/7.5

67