



Analysis
F215 B coal
Laurel Hill Valley CC
most 0.86
vol 23.46
FC 69.56
ash 6.10
su 2.49

A
B
C
E

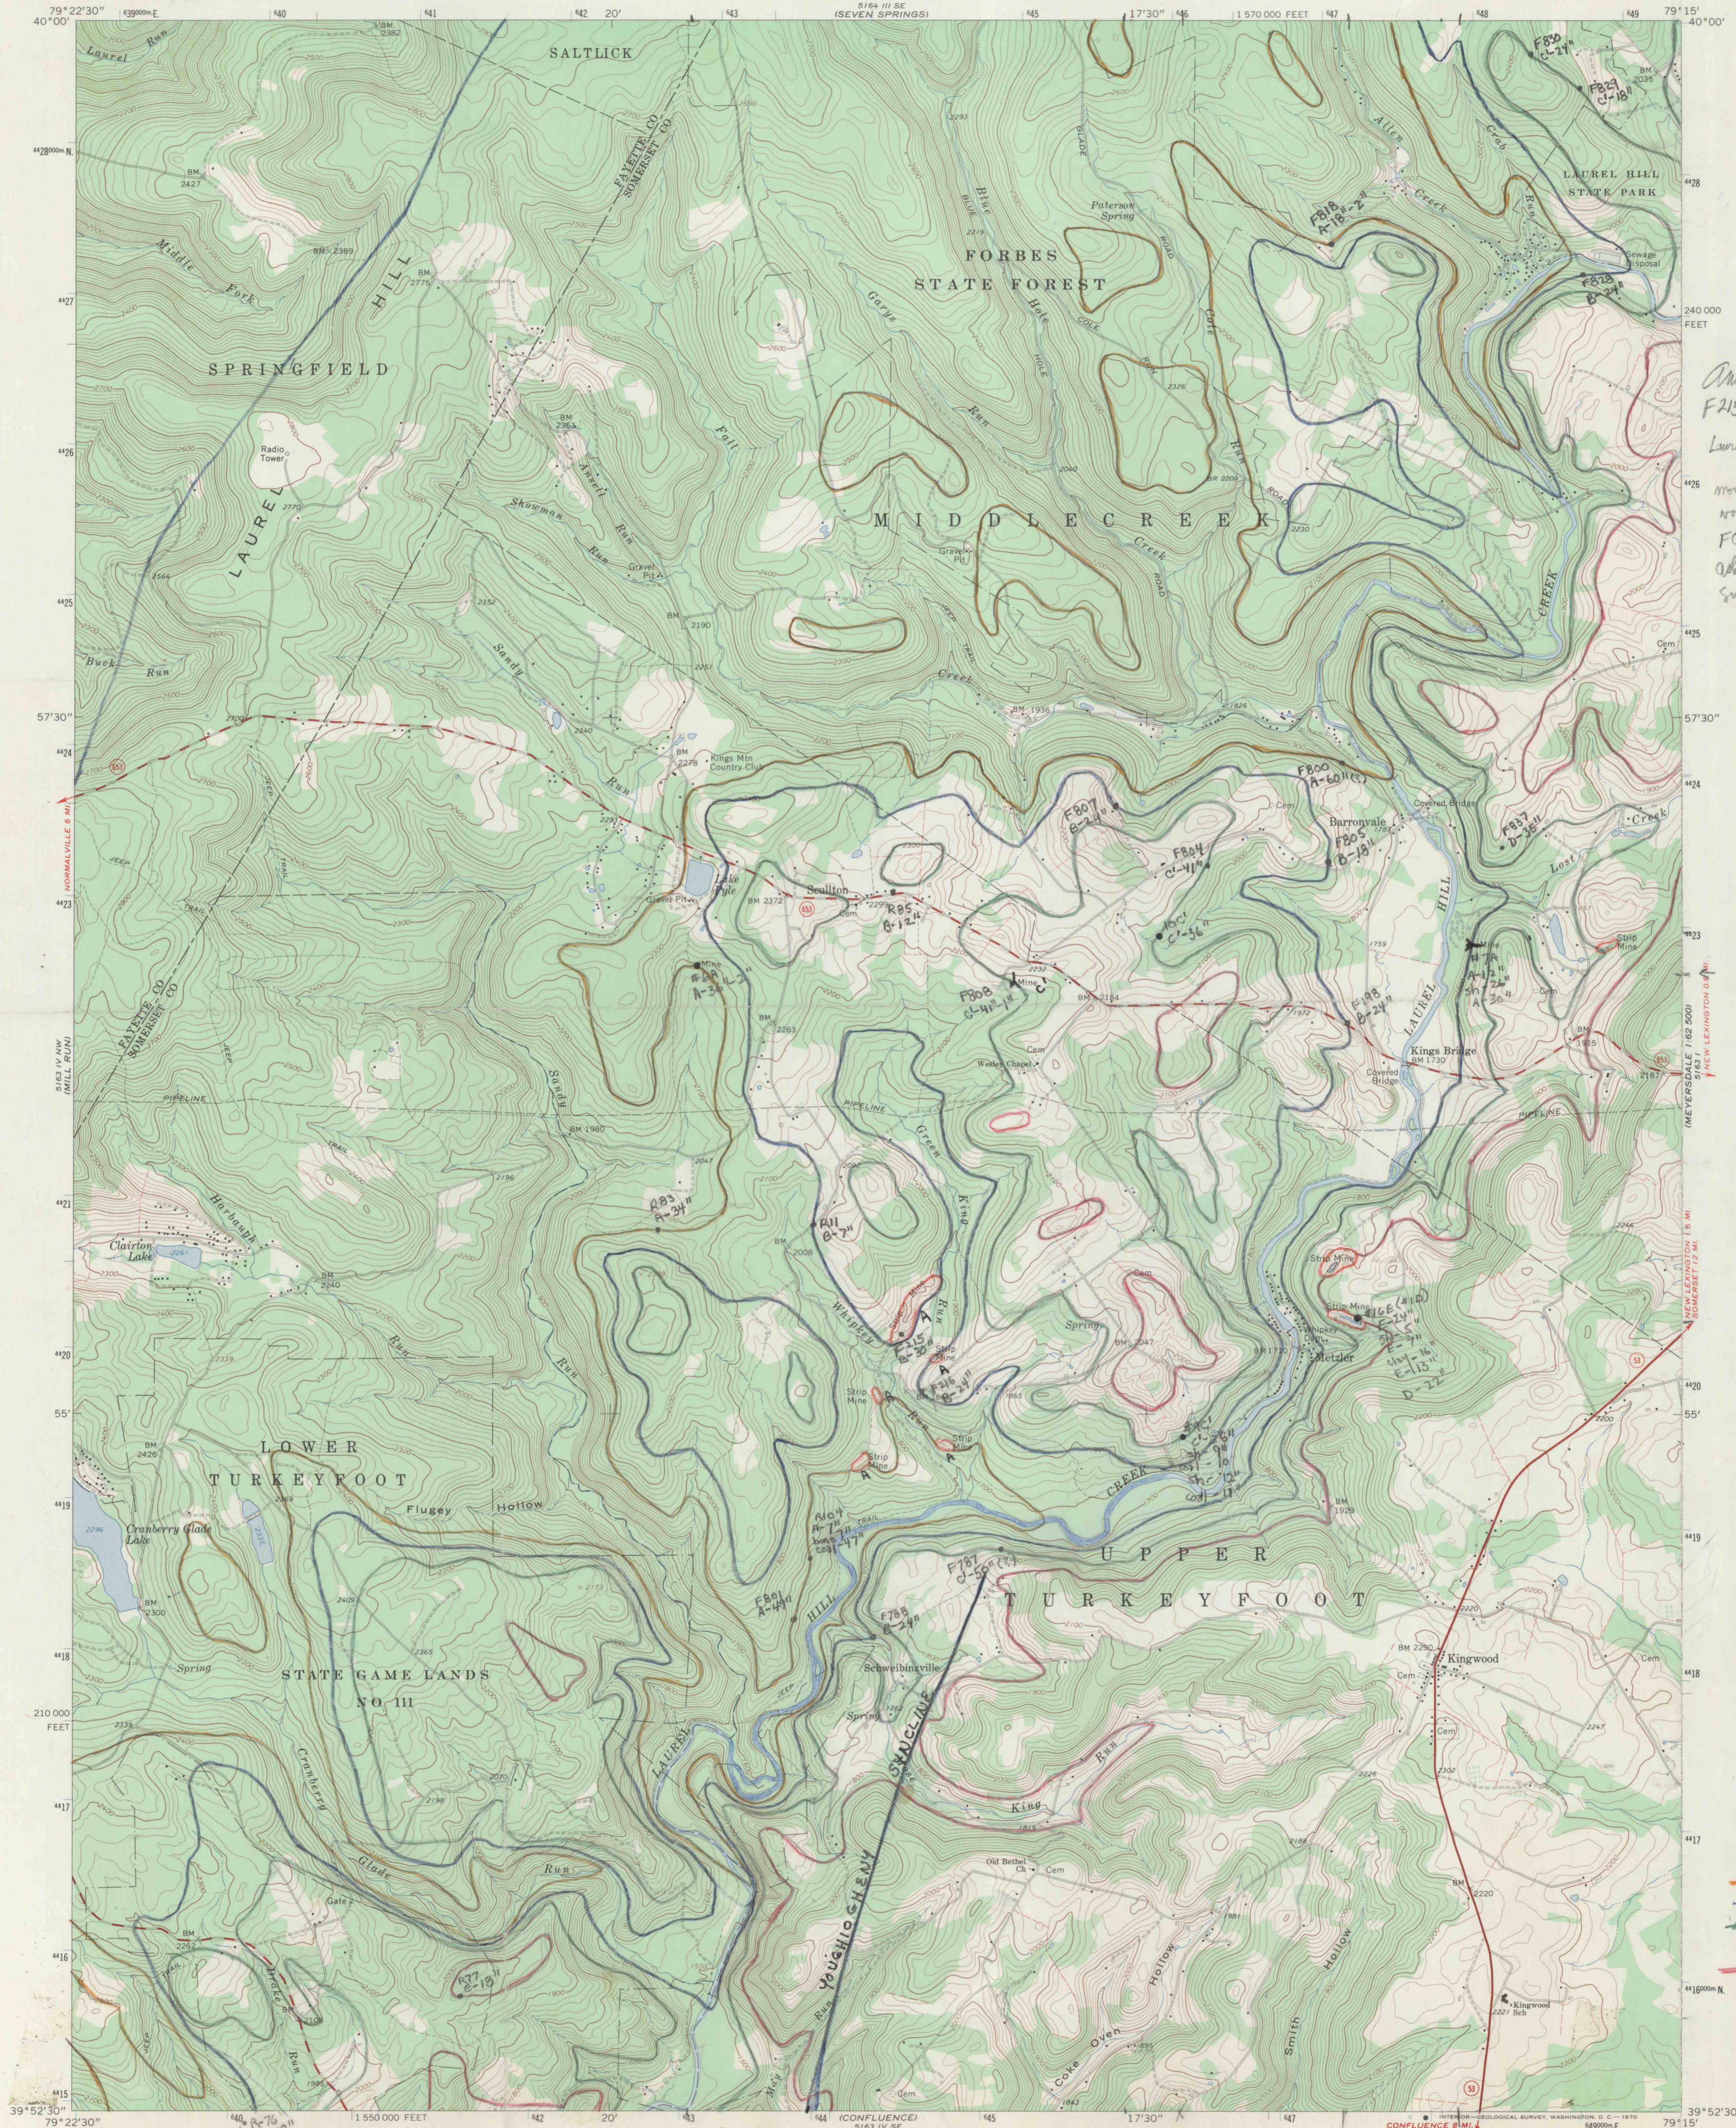

Mapped, edited, and published by the Geological Survey
Control by USGS and USC&GS
Topography by photogrammetric methods from aerial
photographs taken 1966. Field checked 1967
Polyconic projection. 1927 North American datum
10,000-foot grid based on Pennsylvania coordinate system, south zone
1000-meter Universal Transverse Mercator grid ticks,
zone 17, shown in blue
Fine red dashed lines indicate selected fence and field lines where
generally visible on aerial photographs. This information is unchecked

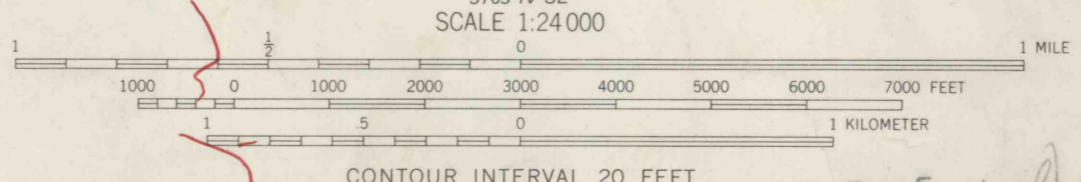

CONTOUR INTERVAL 20 FEET
DATUM IS MEAN SEA LEVEL

• P1+G5 C56A
#6A refers to section 6 of A coal, etc.

ROAD CLASSIFICATION
Primary highway, all weather, hard surface
Secondary highway, all weather, hard surface
Light-duty road, all weather, improved surface
Unimproved road, fair or dry hard surface
State Route

gwin engineers, inc.
Allentown, Pennsylvania
Date FEB 1973

KINGWOOD, PA.
NE 1/4 CONFLUENCE 15' QUADRANGLE
N 3952.5-W 7956.7.5
1967
AMS 5163 IV NE-SER

63