


Put Greene-Clark Co.
boundary on map.

1" = 2.02 miles
= 10,164.5 ft.

Percentage of sulphur in the Pittsburgh coal.

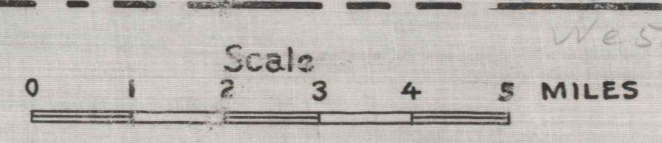

Pennsylvania
West Virginia.