


1" = 2.02 miles
1" = 10.445

Put Green - Shad - Co
boundary on map

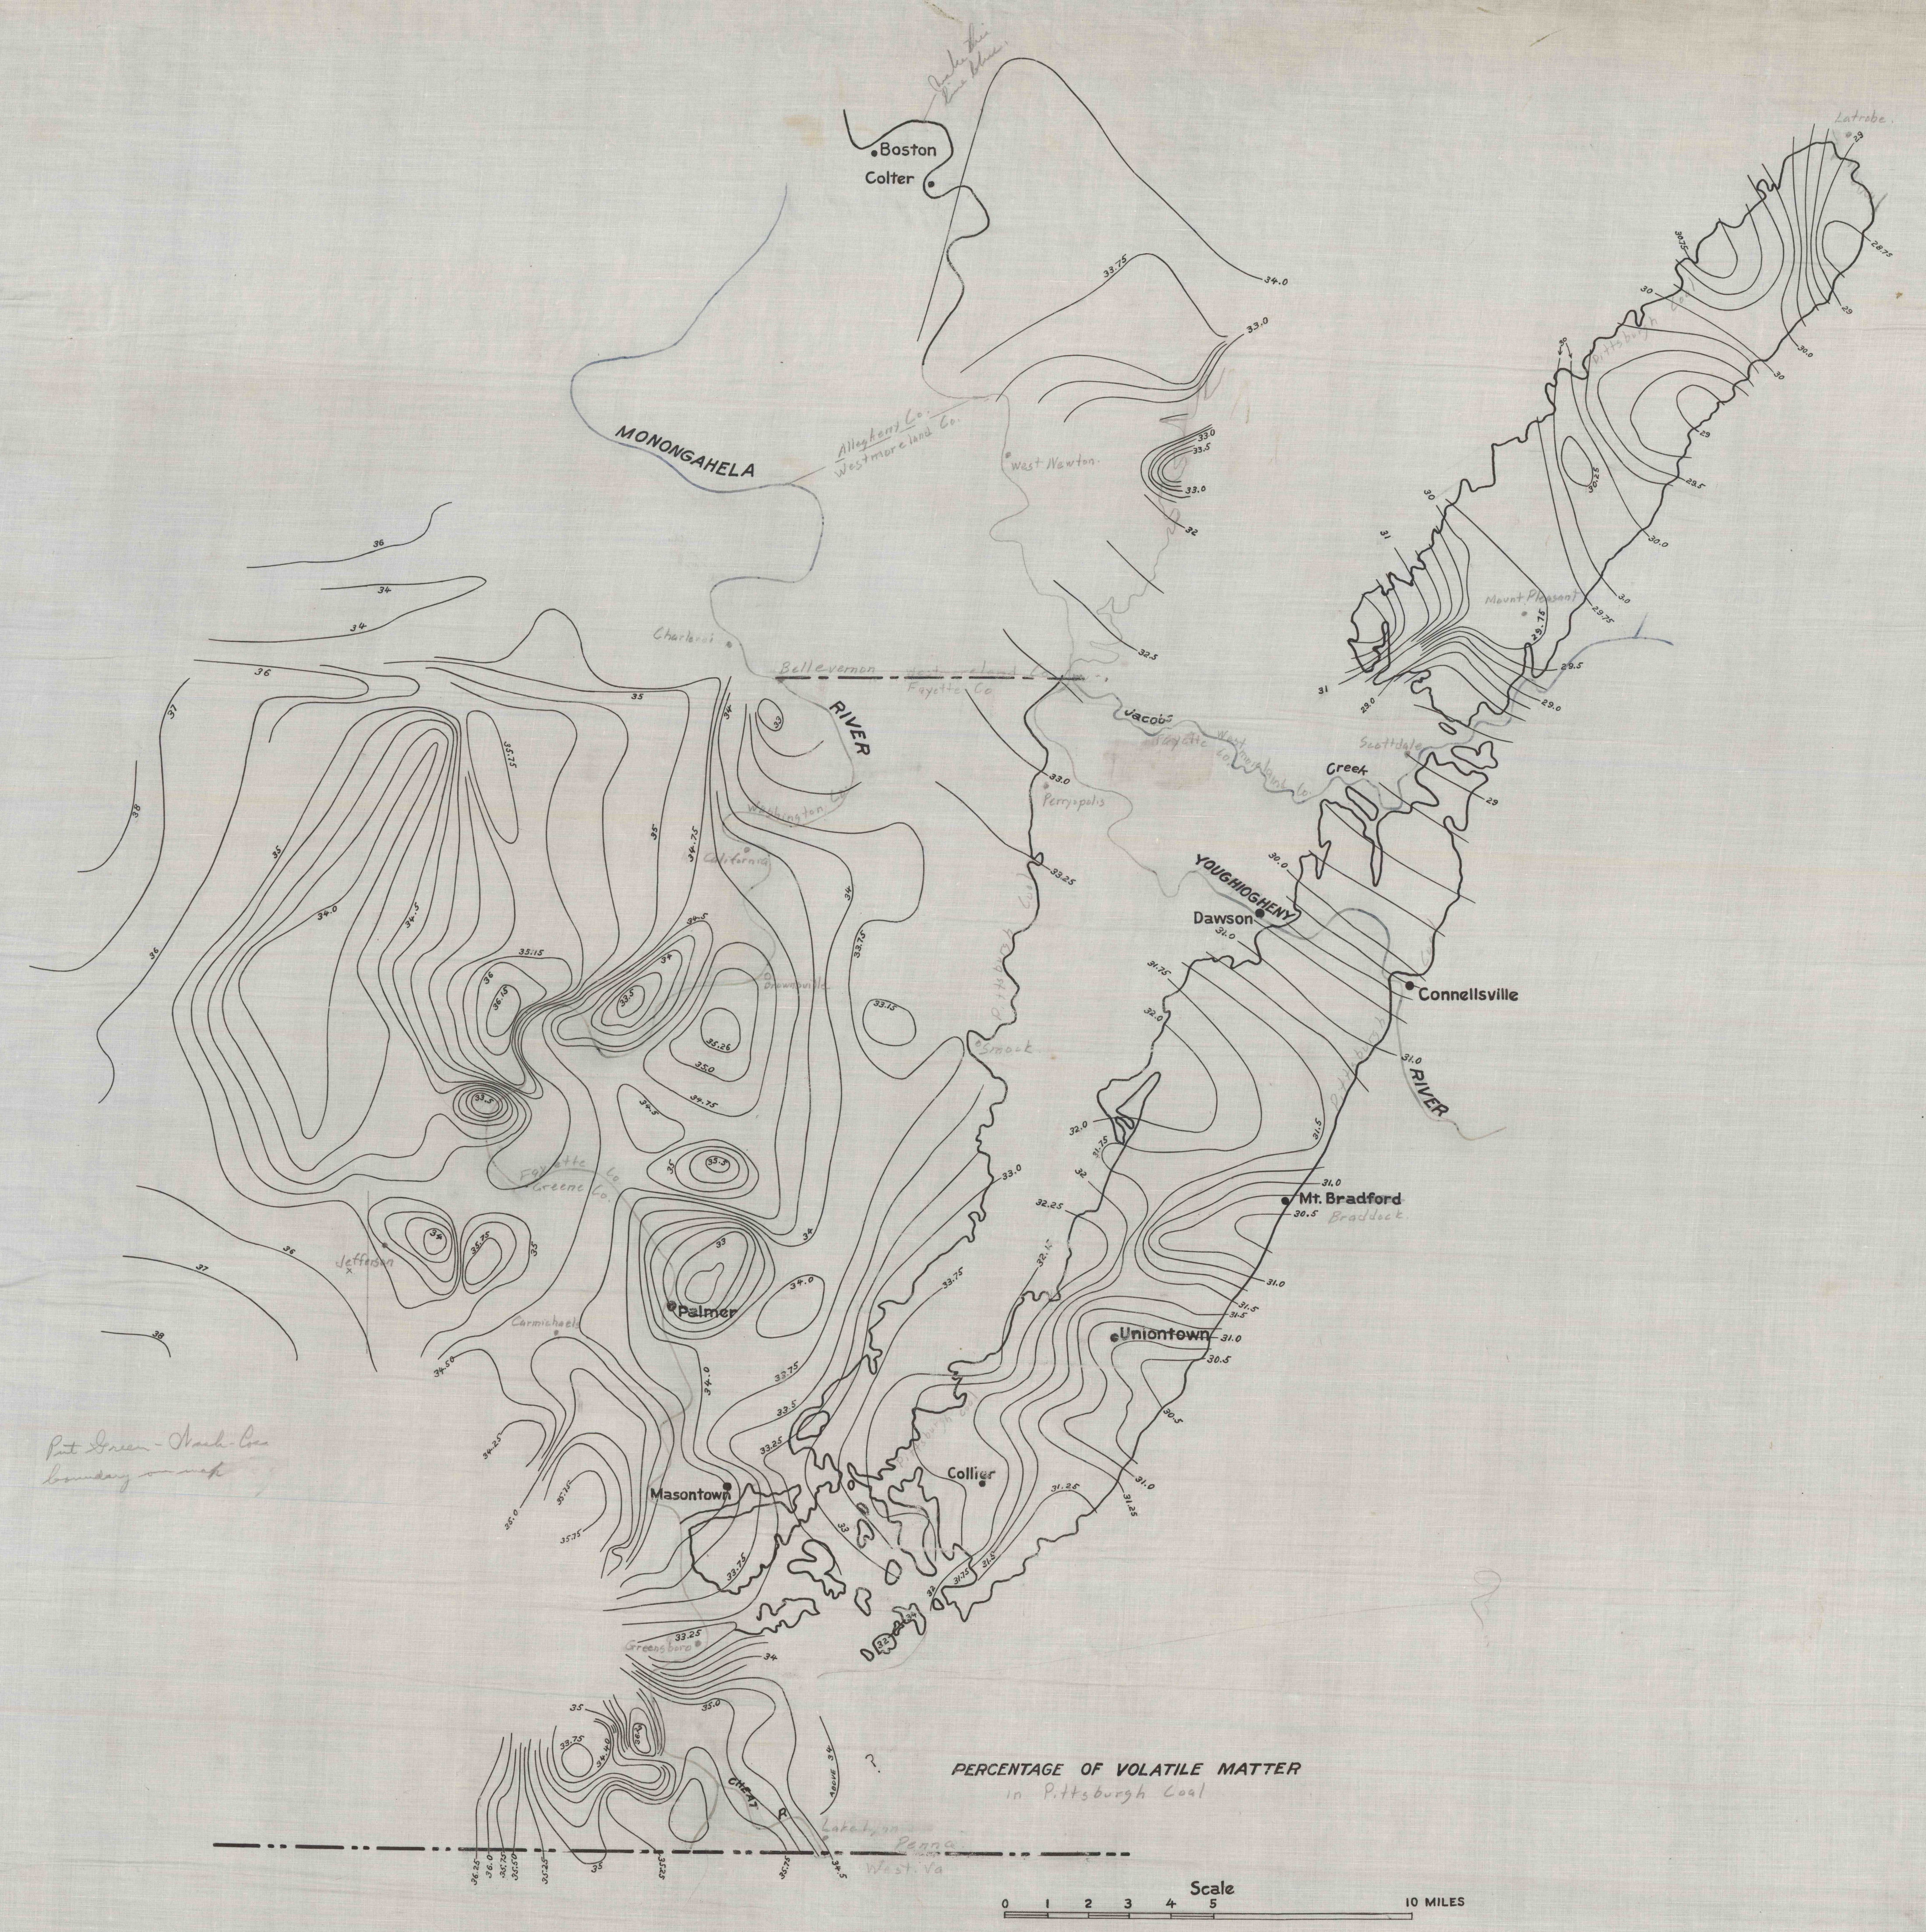

Put Green - Shad - Co

Latrobe

Boston Colter

MONONGAHELA RIVER

Allegheny Co.
Westmoreland Co.

West Newton



FAYETTE CO.

WASHINGTON CO.

Palmer

YOUGHIOGHENY RIVER

Dawson

Connellsville

CONNELLSVILLE

Mt. Bradford

Braddock

Uniontown

Masontown

Collier

Greensboro

West Va