
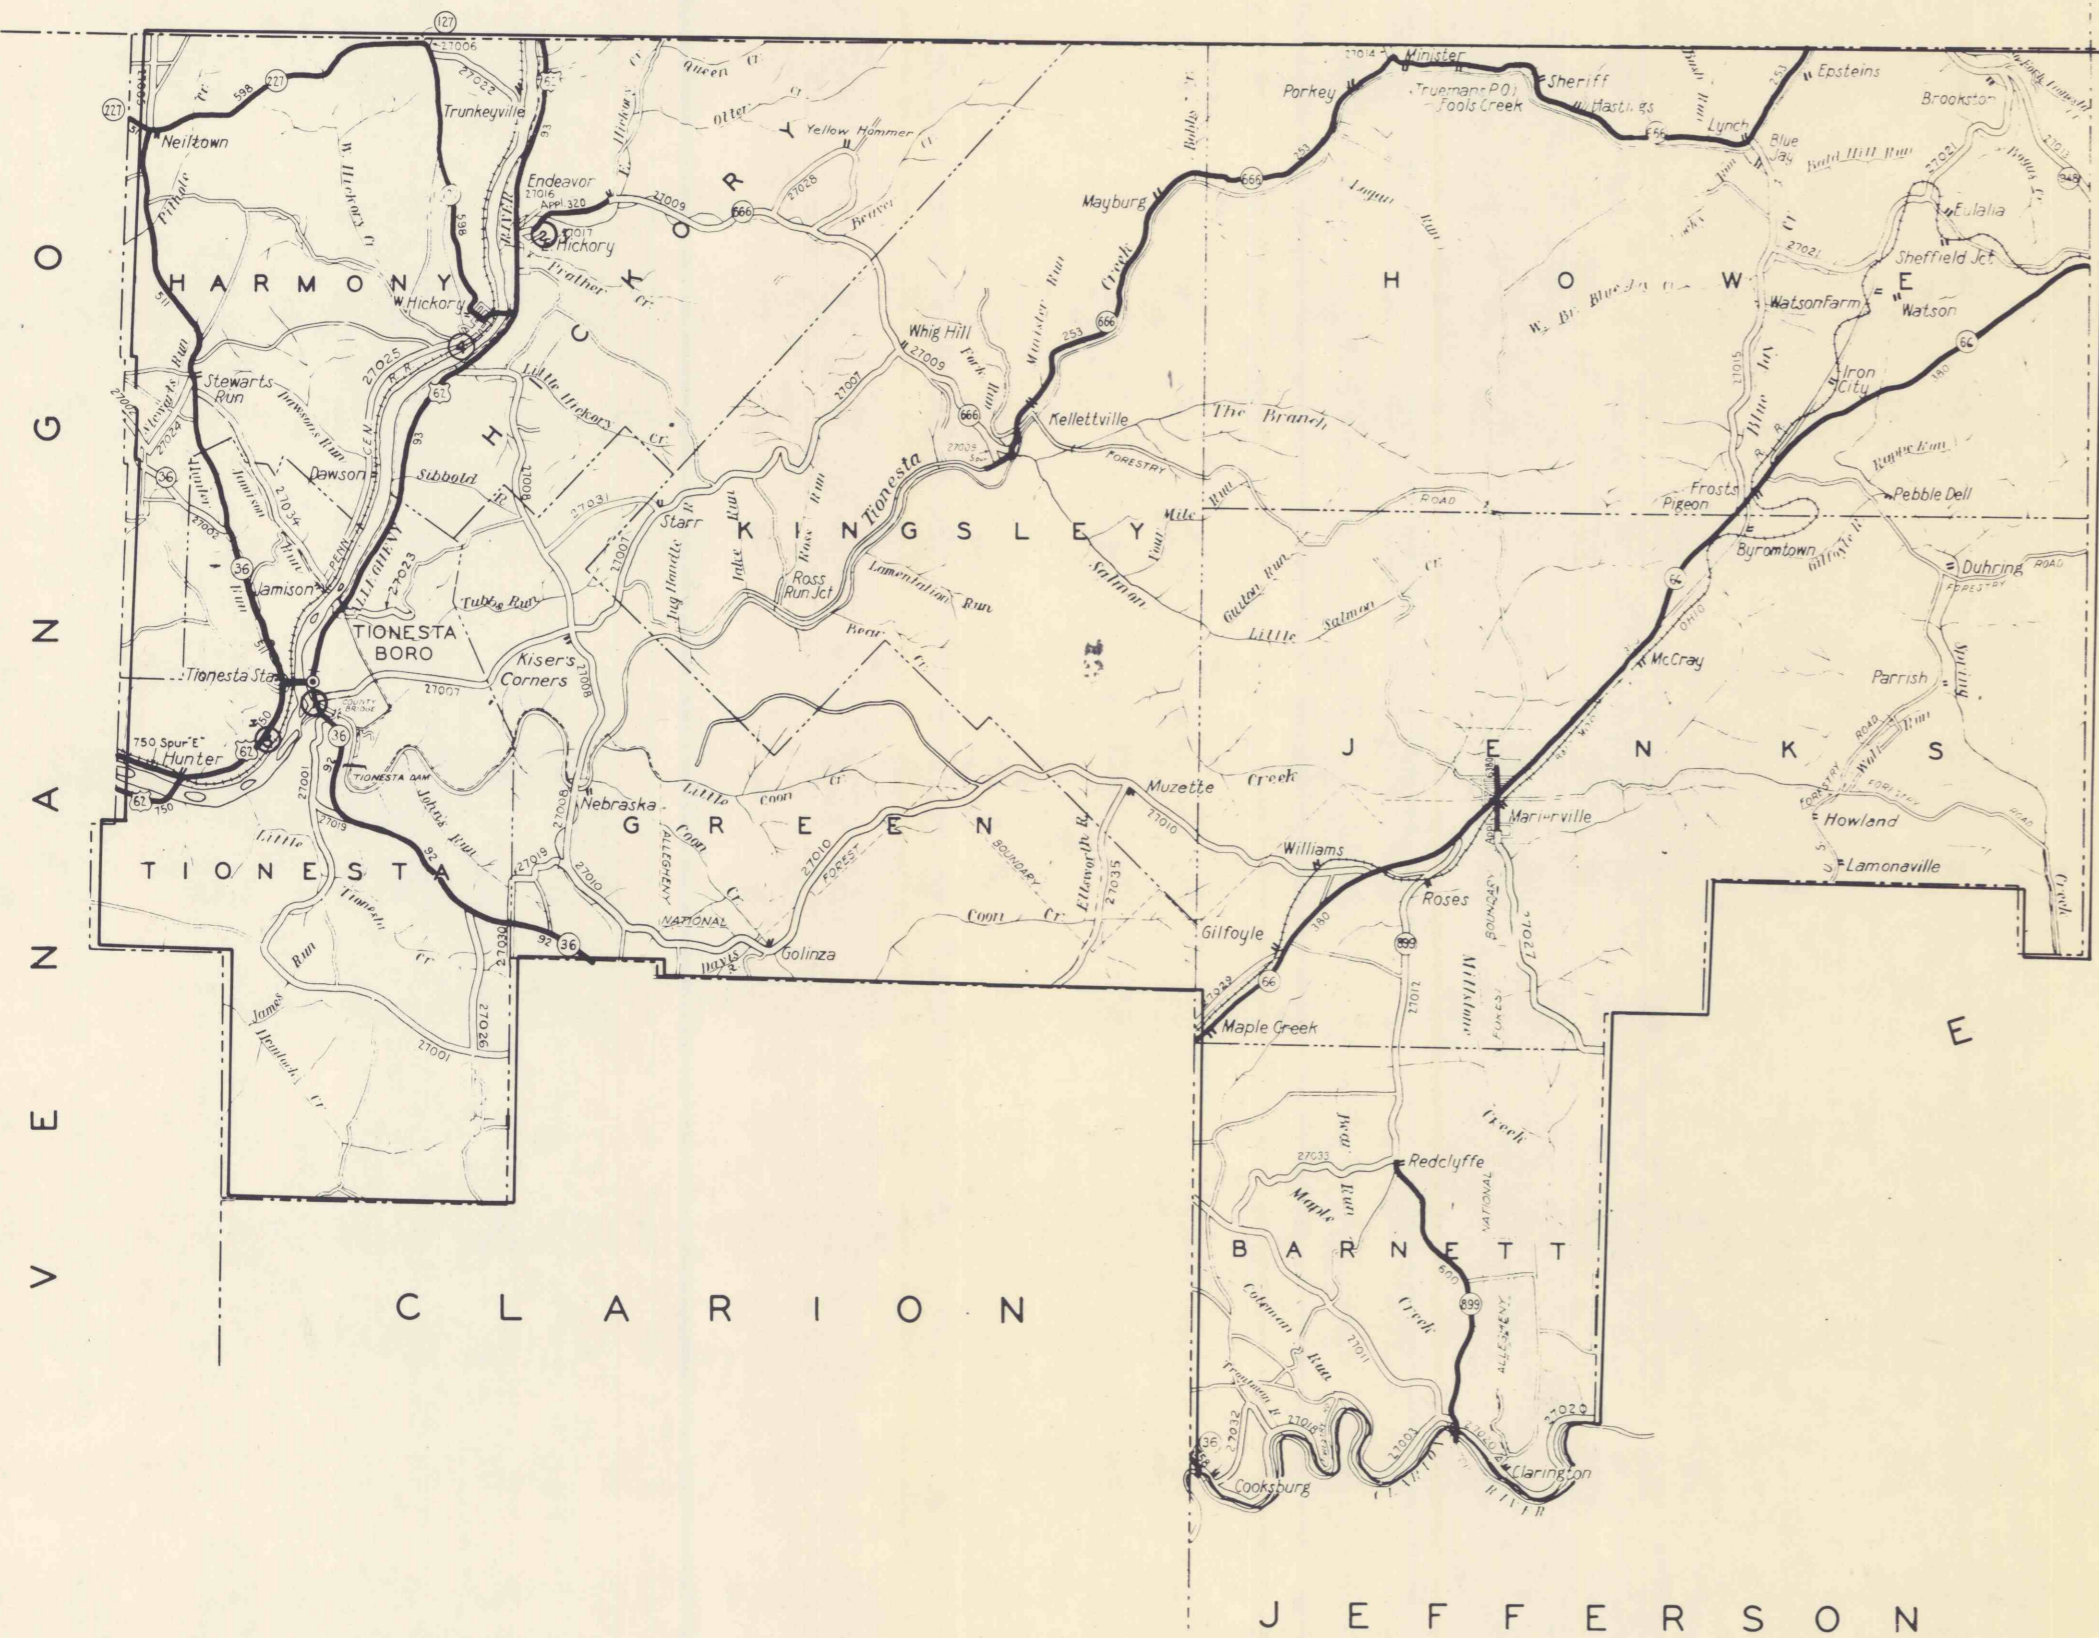


MAP OF FOREST COUNTY

W A R R E N

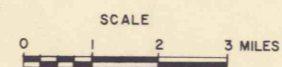

NO.	PRODUCER	SOURCE NAME	ROCK TYPE	FORMATION (GEO. SYMBOL)	DOT TYPE (G32 AGG.)	STATUS	FINE AGG.	LATITUDE NORTH	LONGITUDE WEST
1	TIONESTA SAND & GRAVEL CO. BOX 207 TIONESTA, PA. 16353	TIONESTA PLANT 1	SAND & GRAVEL	Gravel Allegheny R.	X	ACTIVE	✓	41-29-20	79-27-27
2	"	PLANT 2	"	"		INACTIVE		41-35-24	79-24-20
3	"	HUNTERS STA.	"	"		INACTIVE		41-28-30	79-30-10
4	"	WEST HICKORY	"	"				41-33-48	79-25-05

7 1/2' QUAD
 ? TIONESTA (~~at minute~~) NW 1/4 NOT on G32 map
 2 WEST HICKORY
 3 President
 4 West Hickory NOT on G32 map

What was experience of Tionesta S & G at these locations? What type a quality of gravel?

(NA)=Not approved by PennDOT