

lower split

STUDY AREA

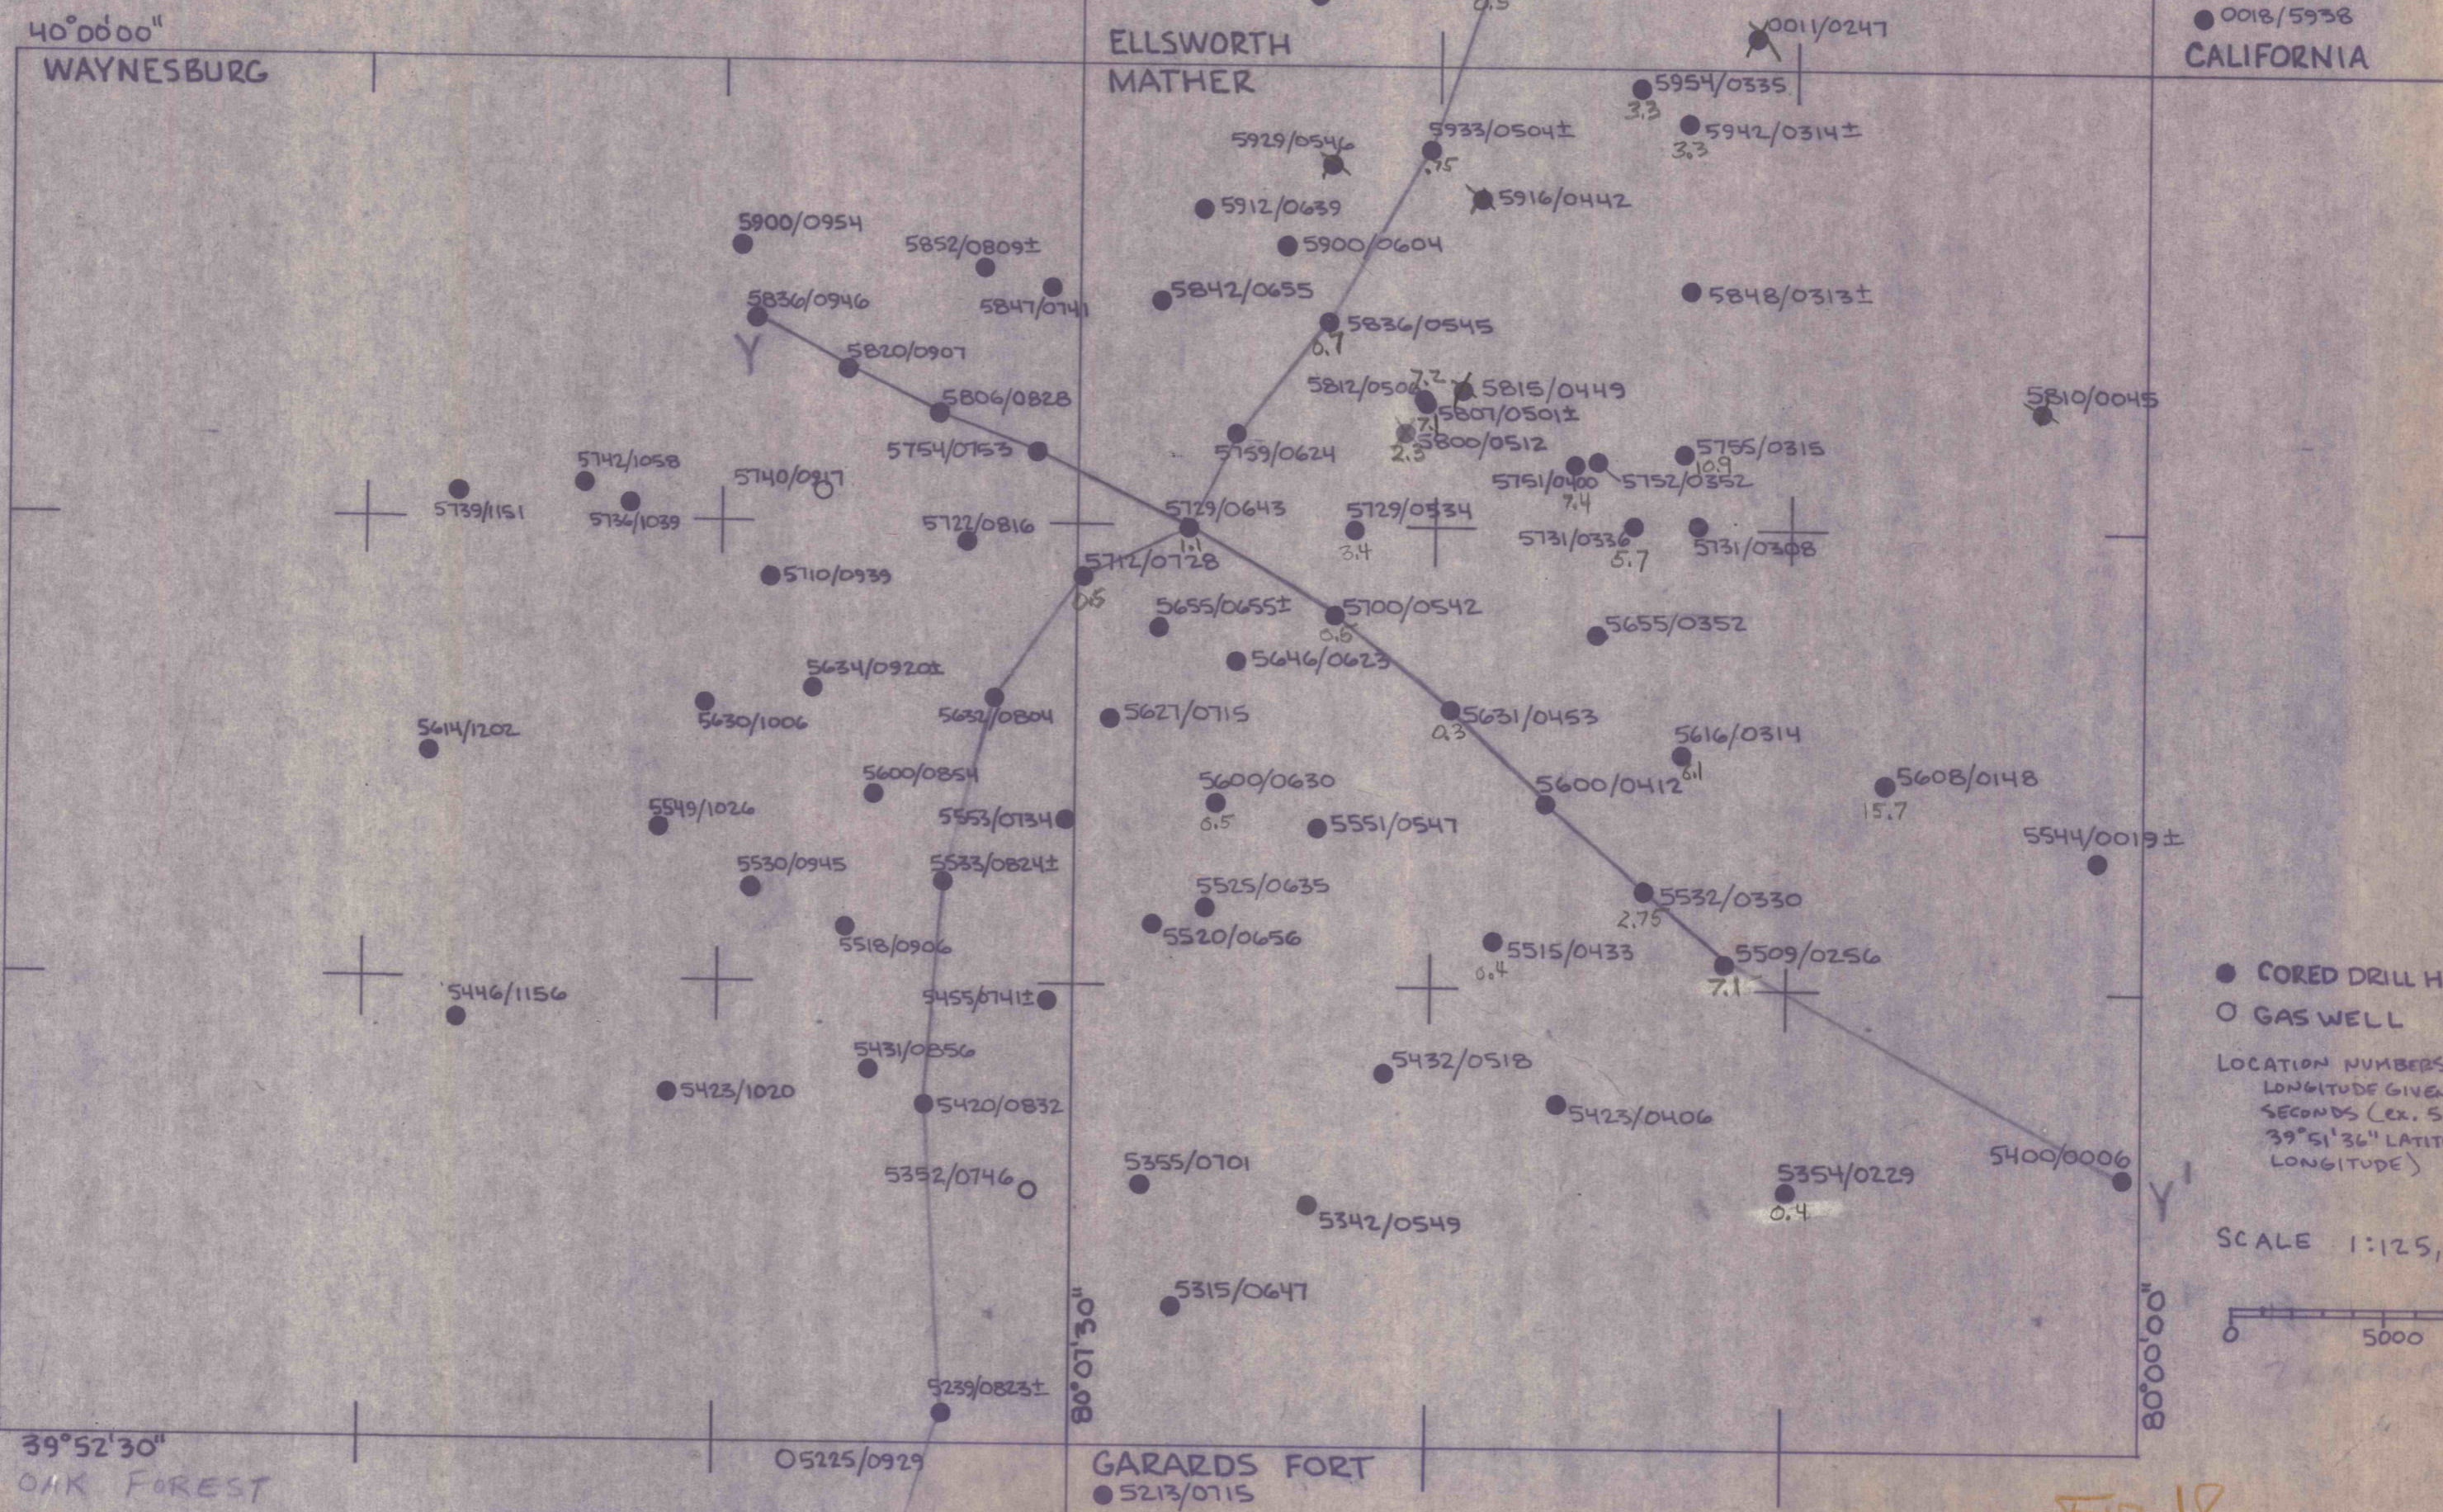
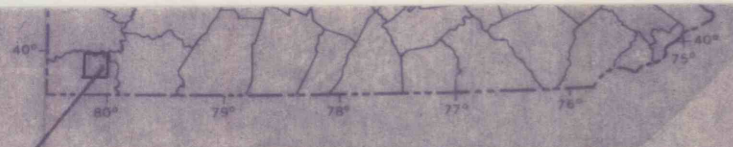


FIG 18