Ignore

Delete

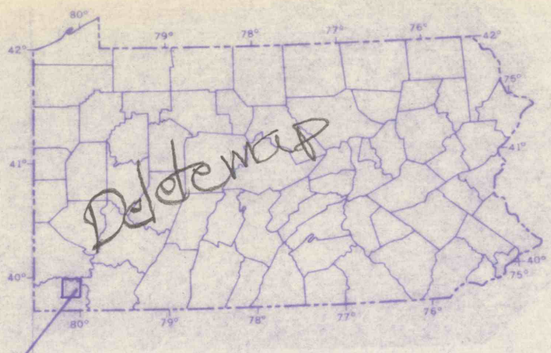

DH #62

40°00'00"

WAYNESBURG

ELLSWORTH

MATHER

CALIFORNIA

80°15'00"

80°00'00"

39°52'30"

OAK FOREST

GARARDS FORT

0122/0500
0104/0428
0115/0259
0049/0340
0022/0552
0031/0439
0011/0247
0057/5939
0041/5905
0018/5938
5954/0335
5942/0314±
5933/0504±
5929/0546
5912/0639
5916/0442
5900/0954
5900/0604
5852/0803±
5842/0655
5836/0946
5836/0545
5848/0313±
5820/0907
5812/0506
5815/0443
5801/0301±
5810/0045
5806/0828
5800/0512
5759/0624
5755/0315
5754/0753
5751/0400
5752/0552
5742/1058
5740/0817
5739/1151
5736/1039
5729/0643
5729/0534
5731/0336
5731/0308
5731/0816
5712/0728
5710/0939
5700/0542
5655/0352
5655/0655±
5646/0623
5634/0920±
5630/1006
5632/0804
5627/0715
5631/0453
5616/0314
5614/1202
5608/0148
5600/0630
5600/0412
5600/0854
5553/0734
5551/0547
5549/1026
5544/0019±
5533/0824±
5530/0945
5525/0635
5532/0330
5520/0656
5518/0906
5515/0433
5509/0256
5455/0741±
5446/1156
5432/0518
5423/0406
5423/1020
5420/0832
5400/0006
5365/0701
5354/0229
5342/0549
5315/0647
5239/0823±
5225/0929
5213/0715
5136/0848

● CORED DRILL HOLE
○ GAS WELL

LOCATION NUMBERS ARE LATITUDE/LONGITUDE GIVEN IN MINUTES AND SECONDS (ex. 5136/0848 IS 39°51'36" LATITUDE, 80°08'48" LONGITUDE)

0 5000 10000 ft

Y

Y'

Z

Fig. 4 THICKNESS MAP OF SANDSTONE ABOVE THE UPPER FREEPORT COAL.

Fig. 1 LOCATION MAP