


Winkley's Tr

SHEET No 5

SHEET No 4


TO FIT

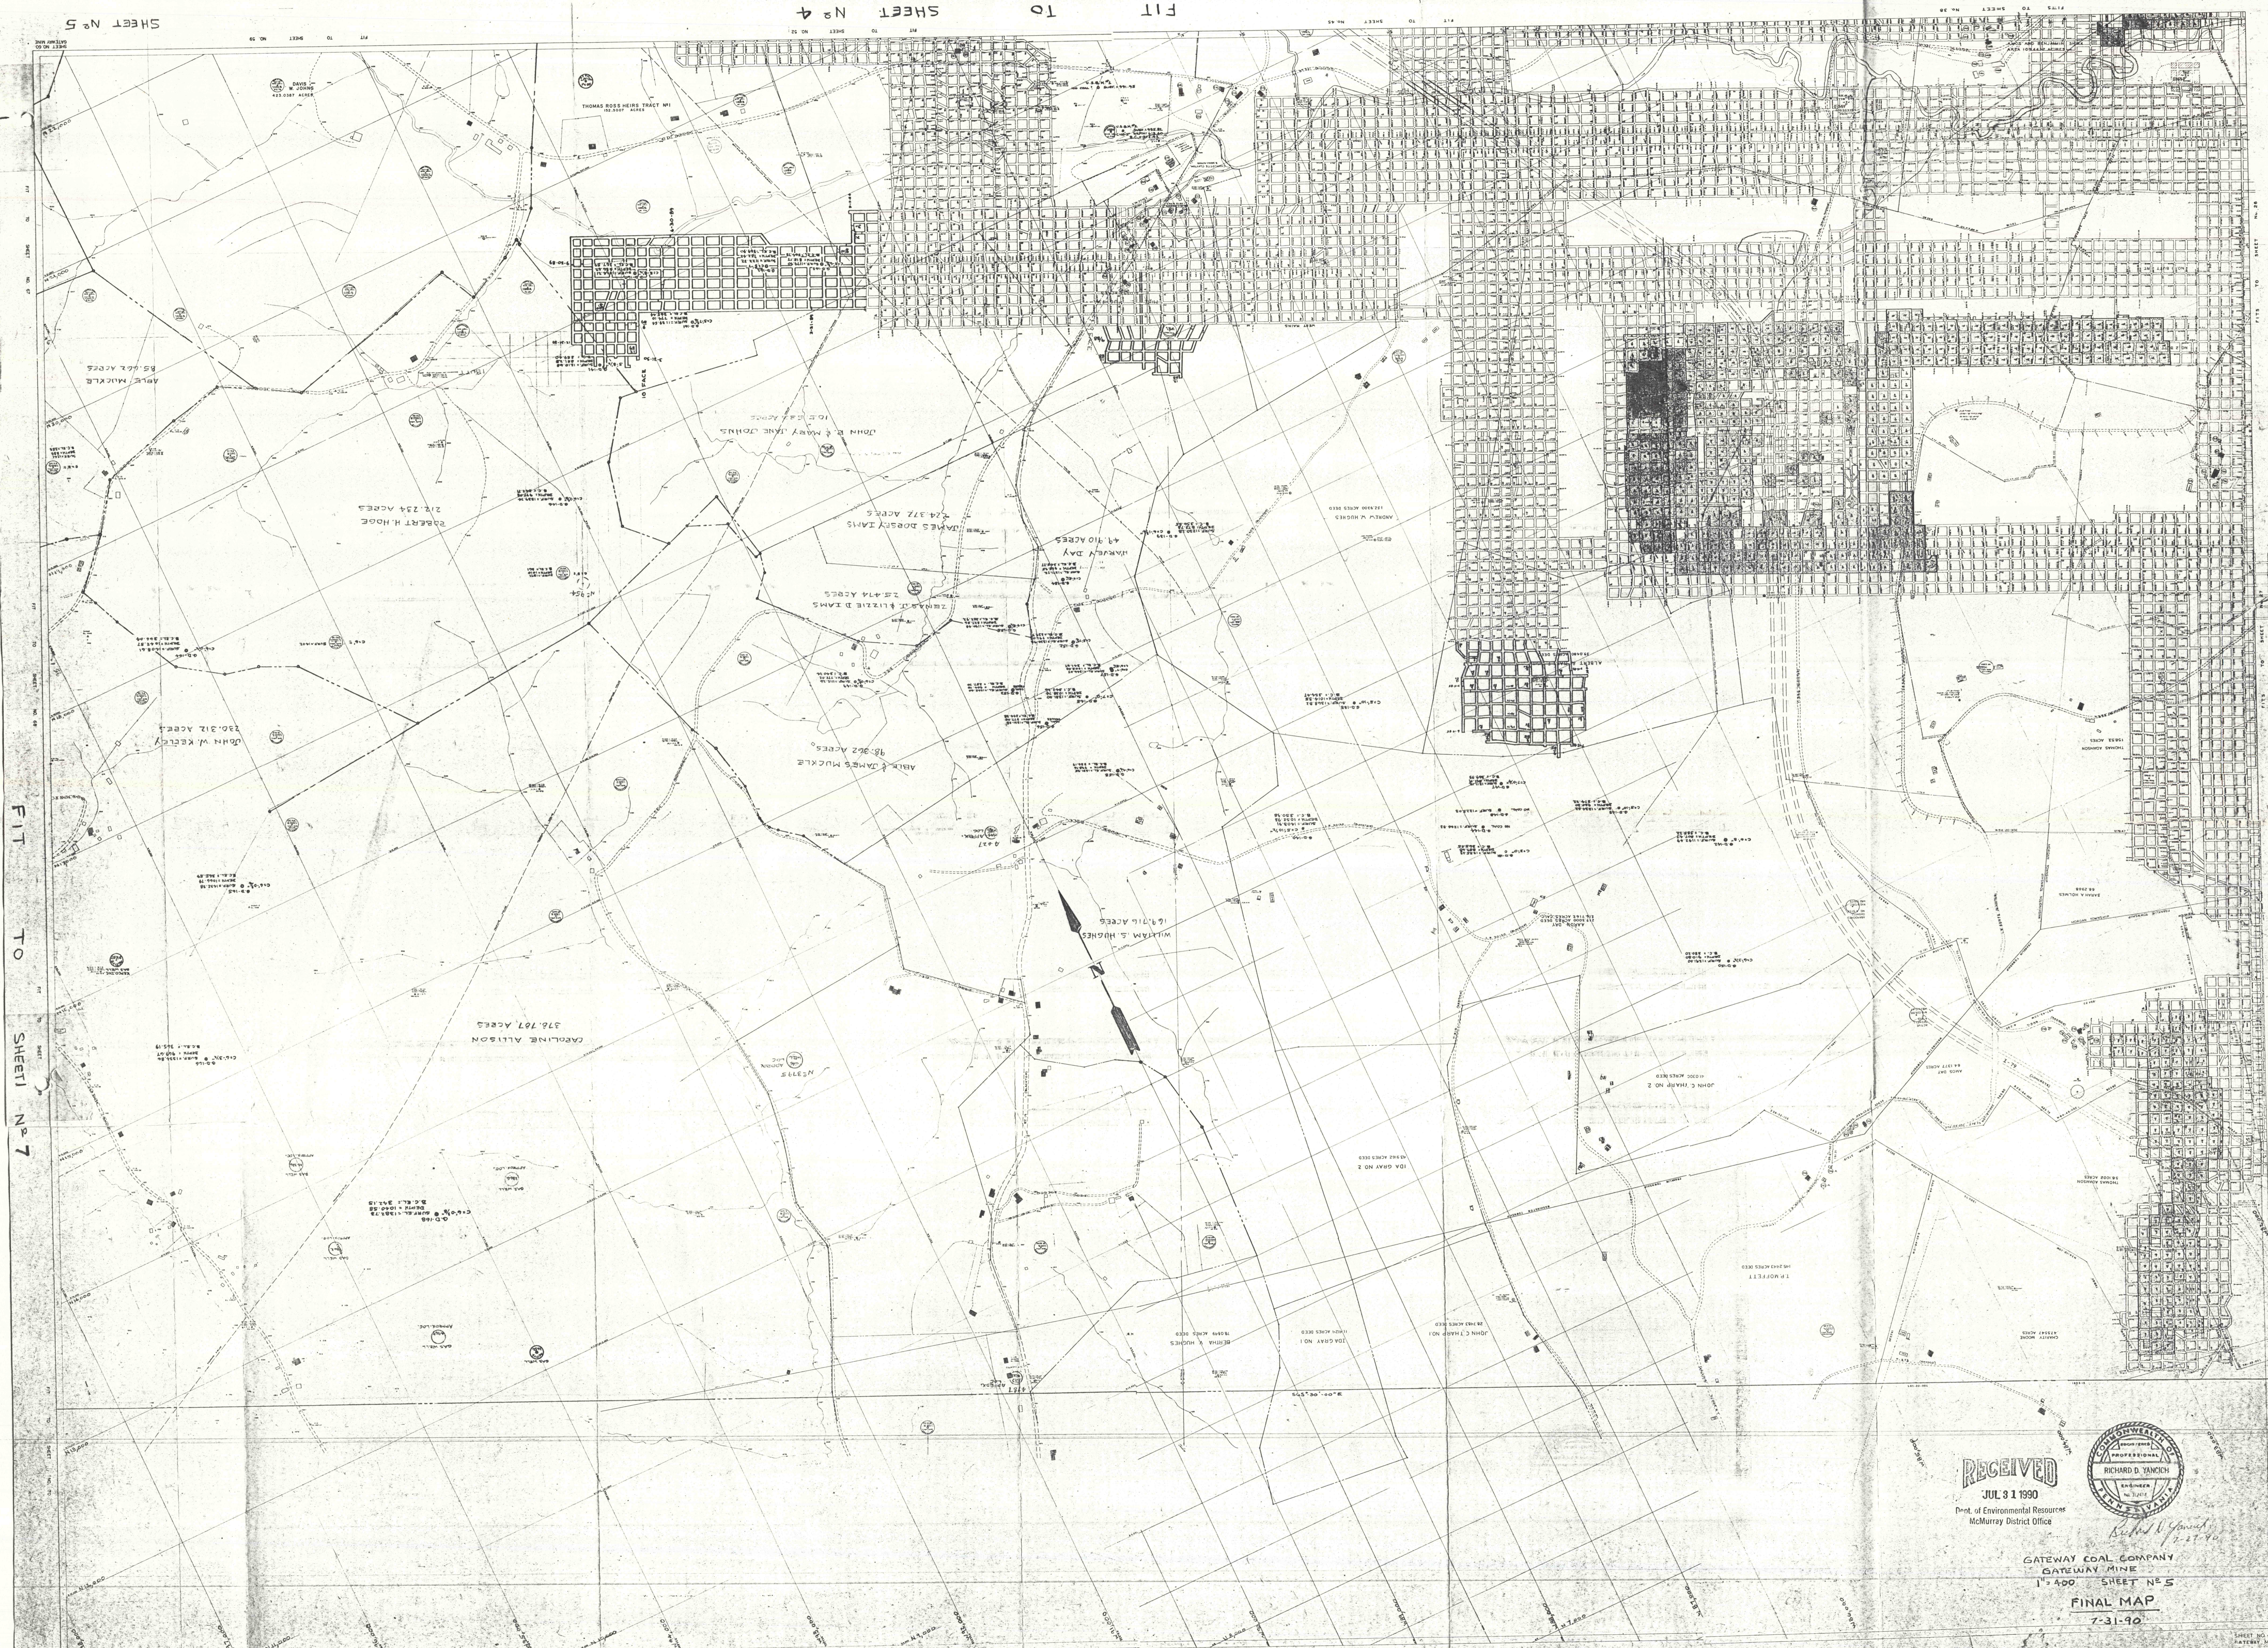

FIT TO SHEET No 7

FIT TO SHEET No 3

RECEIVED  
JUL 31 1990  
Dept. of Environmental Resources  
McMurrey District Office

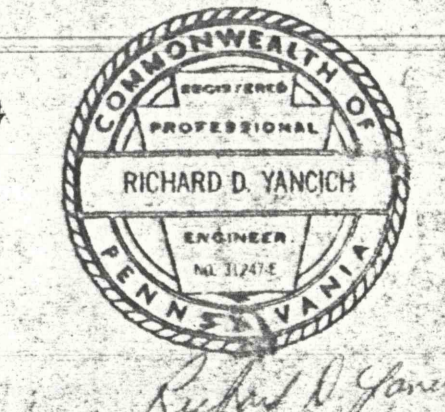

GATEWAY COAL COMPANY  
GATEWAY MINE  
1" = 400' SHEET No 5  
FINAL MAP  
7-31-90

SHEET No 5