


PT TO SHEET No 1

2,000

RECEIVED
JUL 31 1990
Dept. of Environmental Resources
McMurry District Office

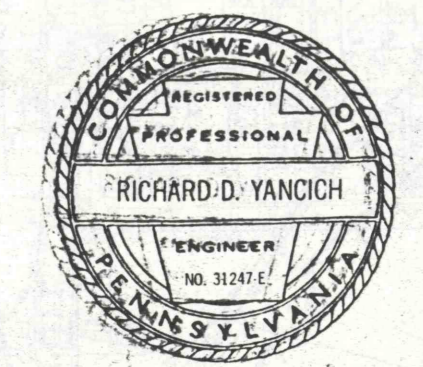

SHEET
2

GATEWAY COAL COMPANY
GATEWAY MINE
1" = 400'
FINAL MAP
SHEET No 2 7-31-90