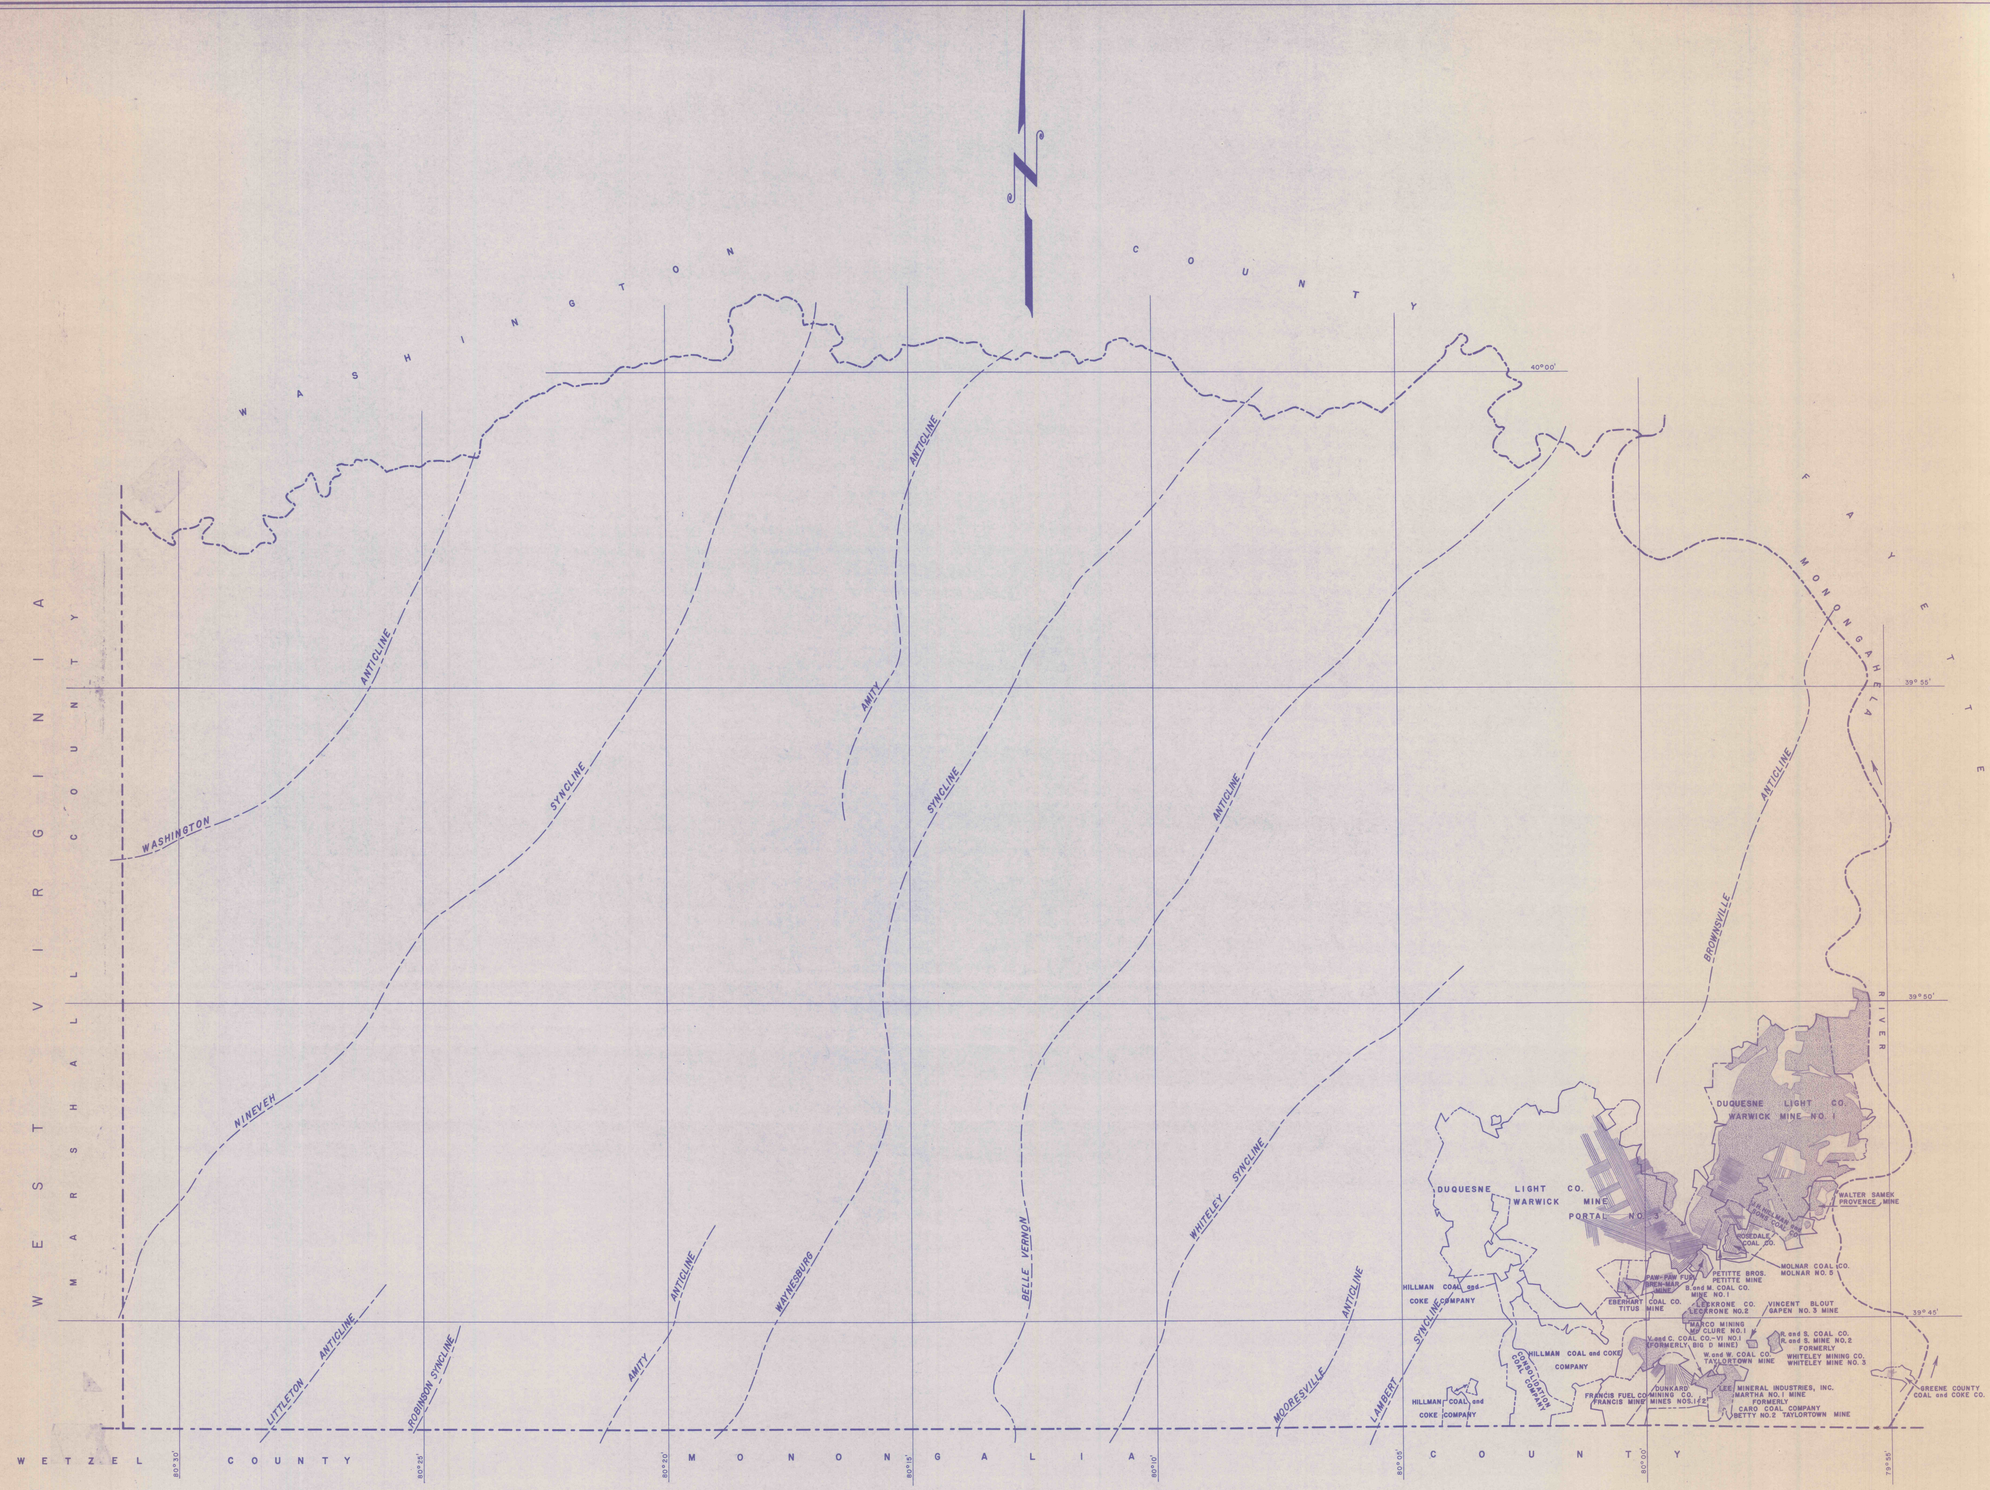

COMMONWEALTH OF PENNSYLVANIA
DEPARTMENT OF ENVIRONMENTAL RESOURCES
BUREAU OF LAND PROTECTION
DIVISION OF MINE SUBSIDENCE REGULATION
MINE MAP
OF
GREENE COUNTY, PA.

JULY-1975

MINING COMPLETED AREAS
SEWICKLEY COAL SEAM

0 2 Miles
SCALE