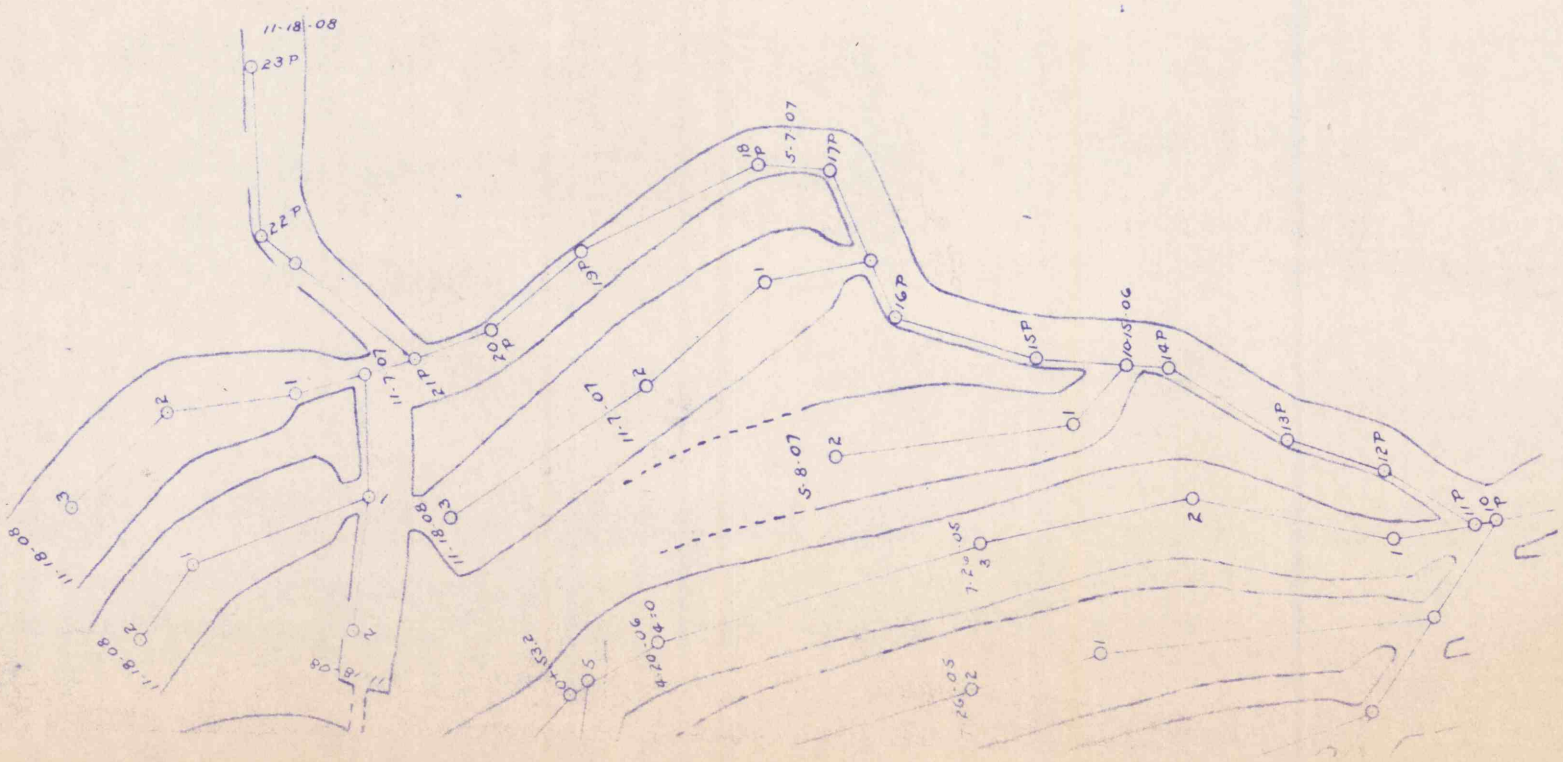
11-18-08
23P
22P
21P
20P
19P
18P
17P
16P
15P
14P
13P
12P
11P
10P
11-7-07
S-7-07
S-8-07
11-18-08
11-8-08
7-20-05
4-20-06
4-20-04
5-32-2
26-05